TOWNSHIP 5 SOUTH, RANGE 2 WEST, WM

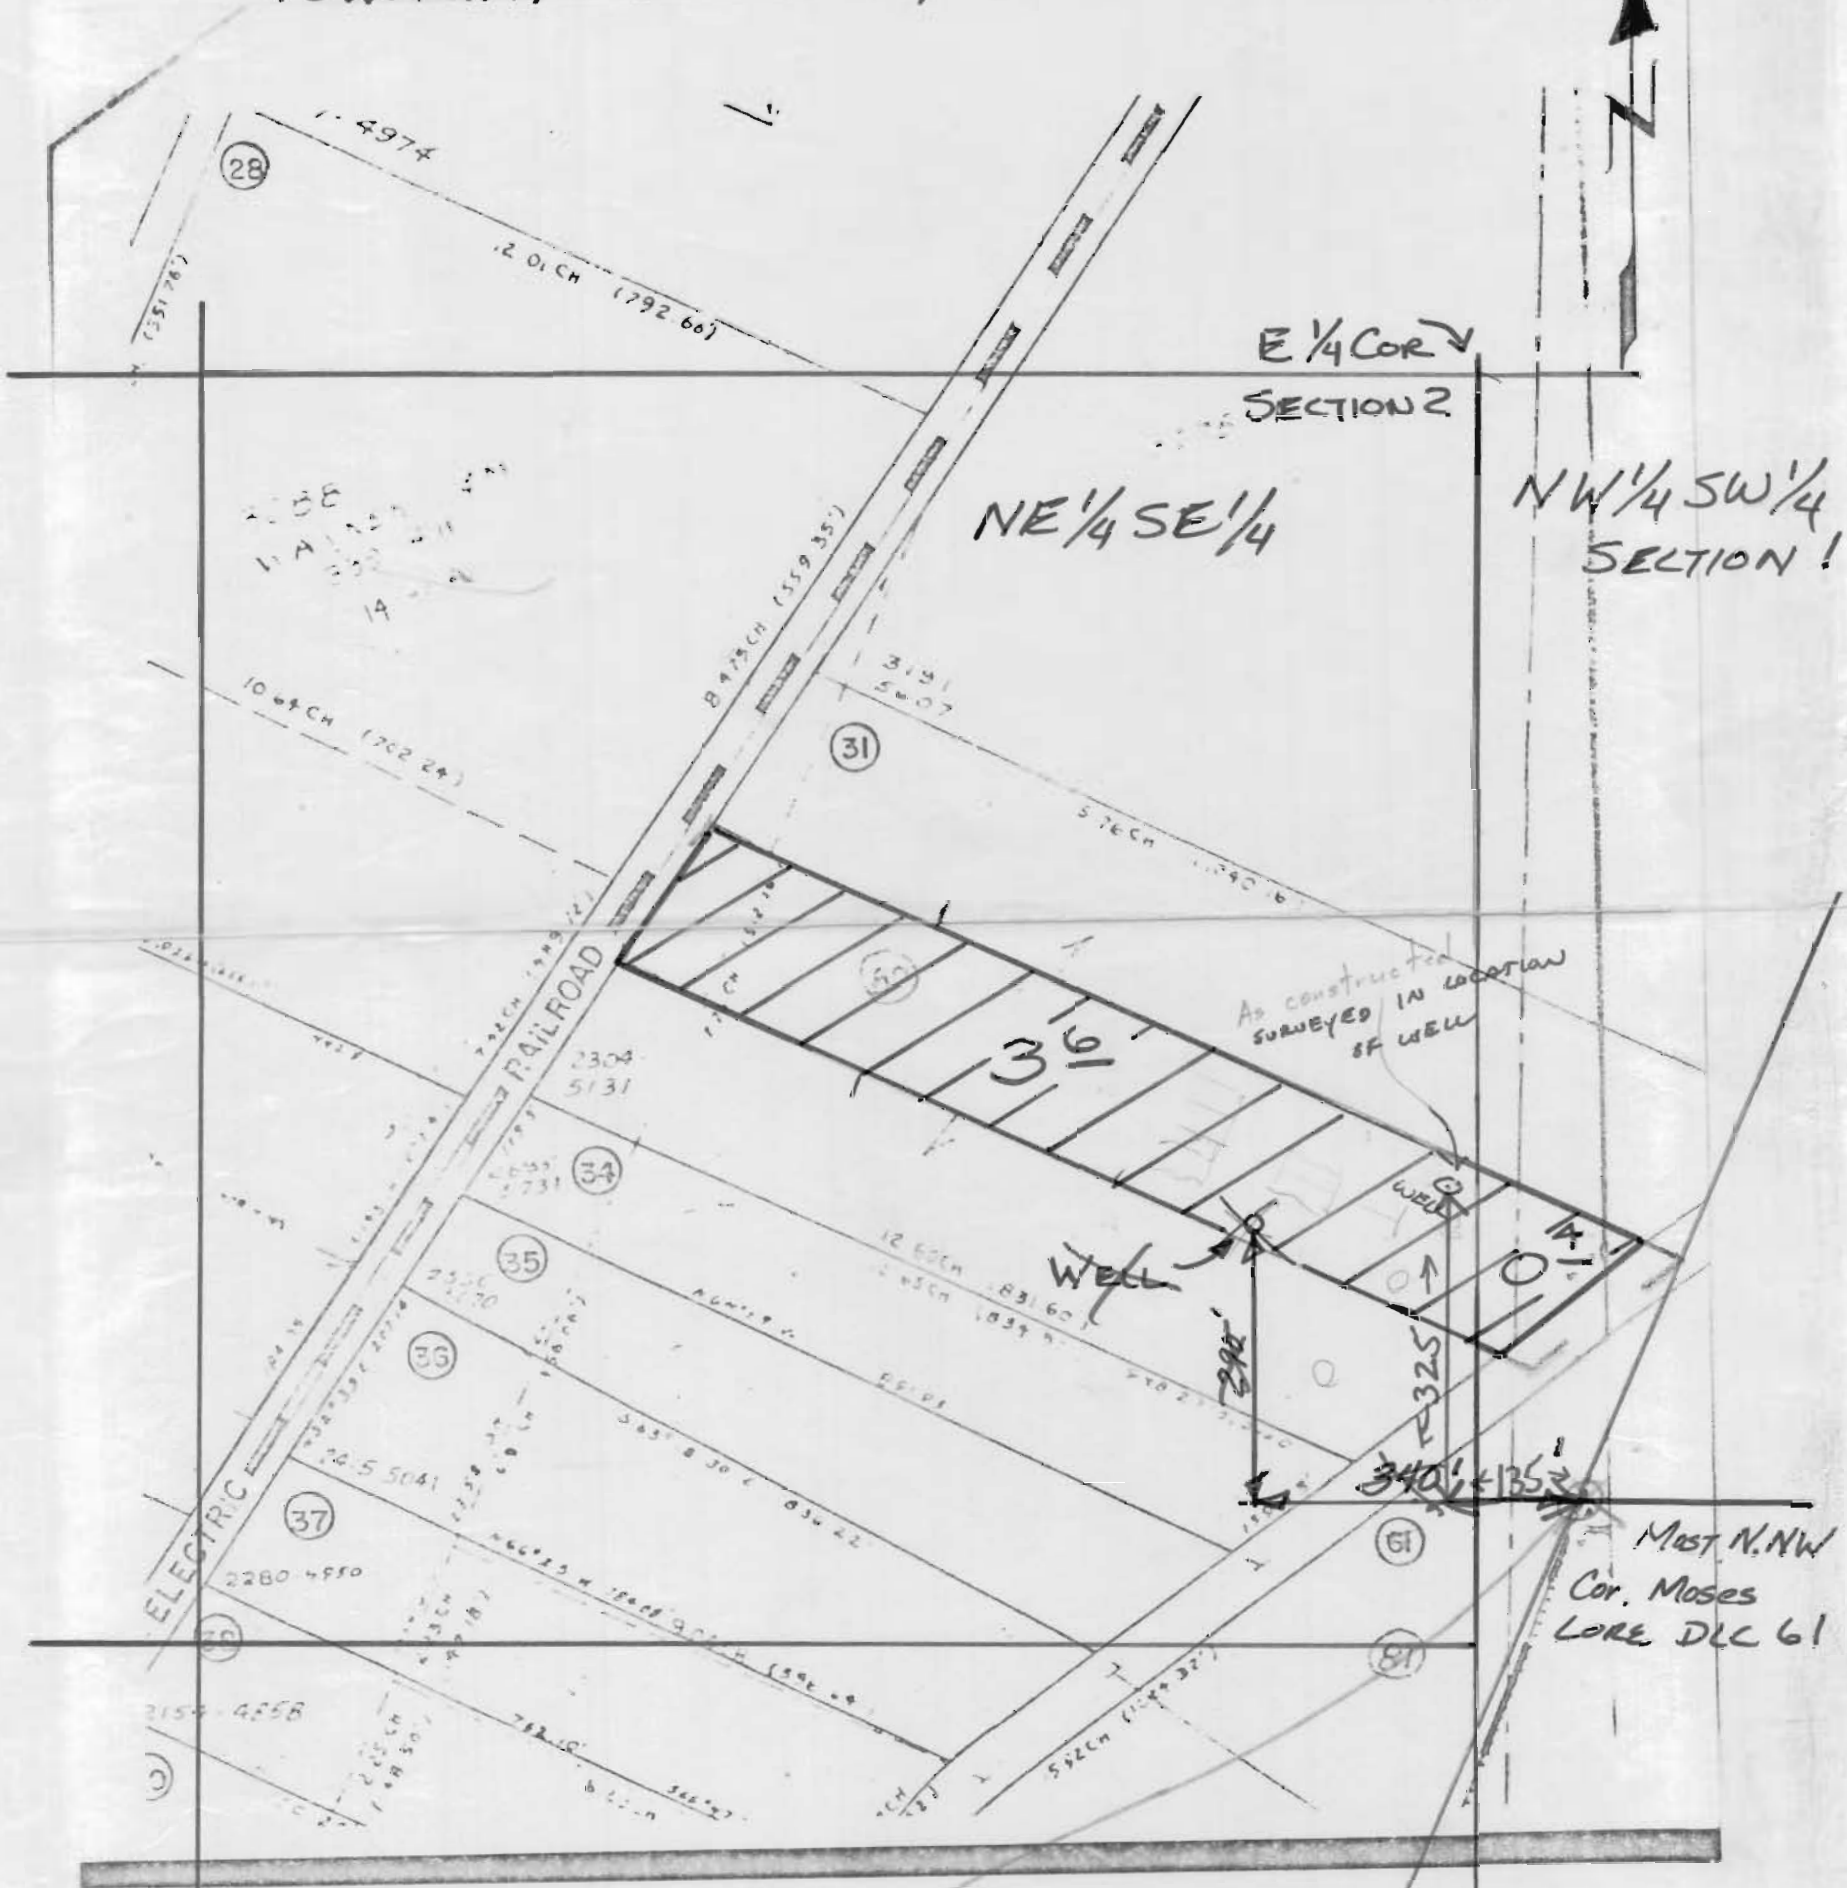

SCALE 1" = 200'

RECEIVED
JUN 30 1982
WATER RESOURCES DEPT.
SALEM, OREGON

Application No. ~~637~~ G-10763
Permit No. G 9826