


Application No. G 9583
Permit No. G 9866

Scale 1"=400'



26

36

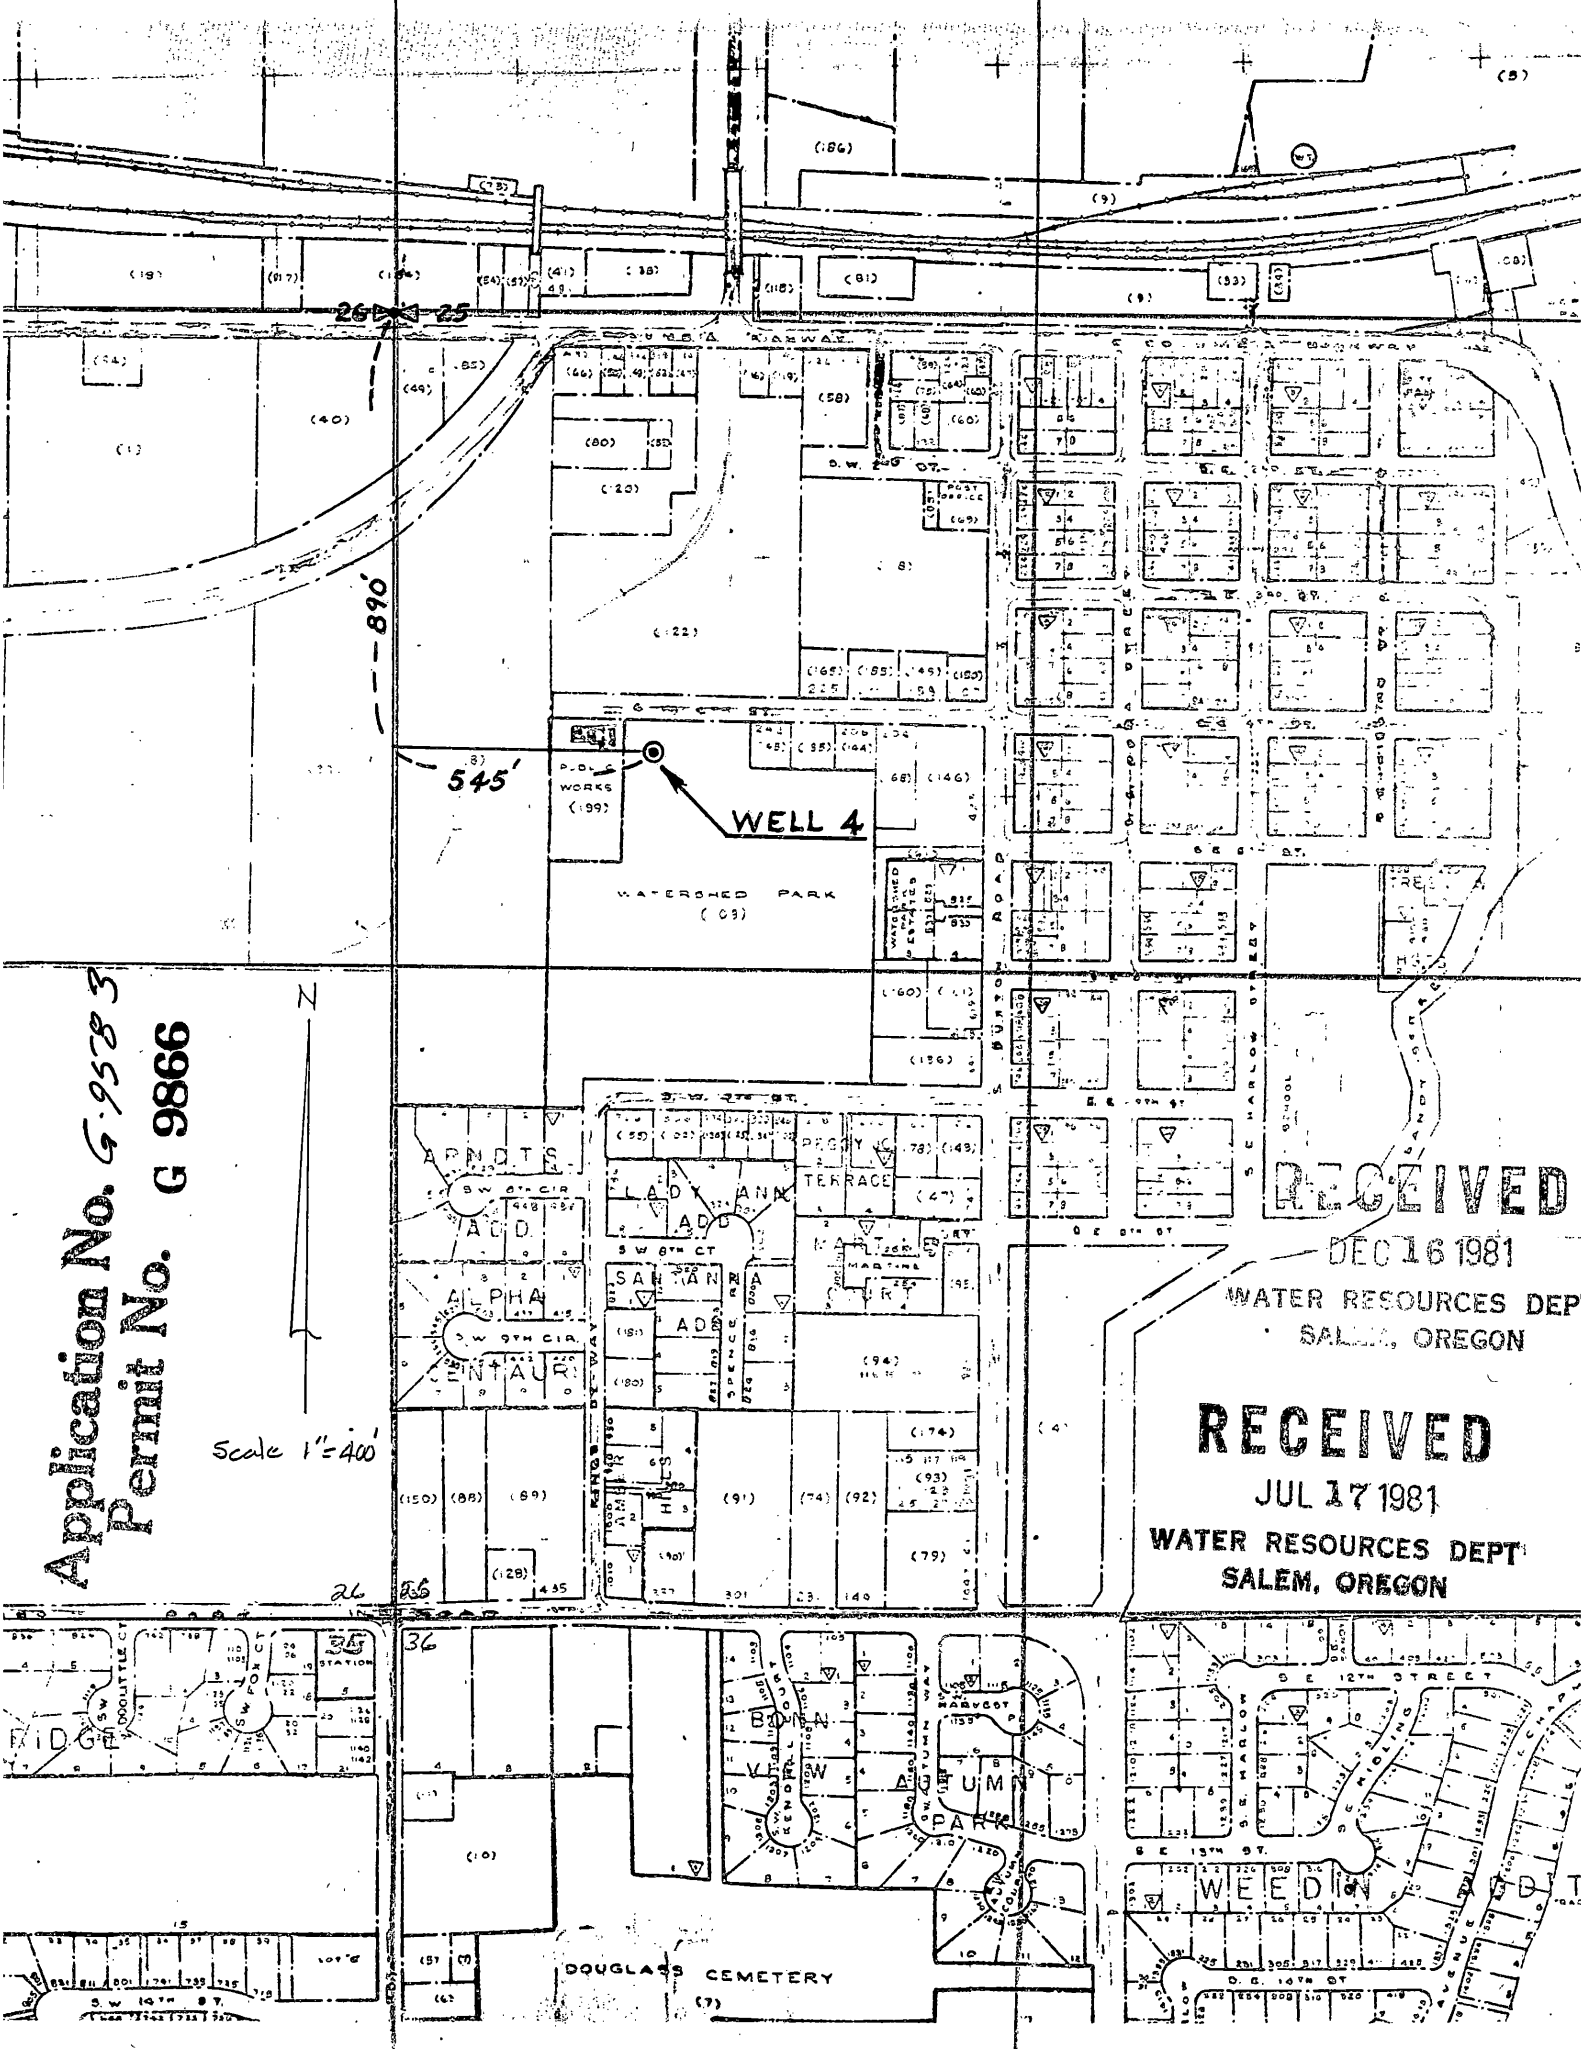

RECEIVED
DEC 16 1981

WATER RESOURCES DEP
SALEM, OREGON

RECEIVED

JUL 17 1981

WATER RESOURCES DEPT
SALEM, OREGON