


T. 3 N., R. 34 E., W.M.

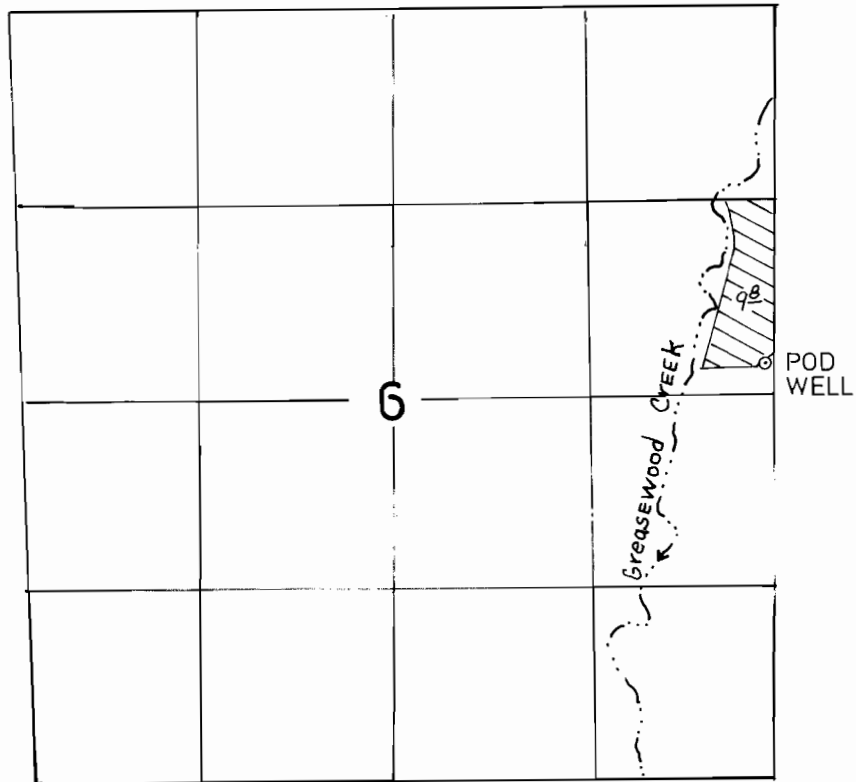

POD 2450' S. AND 50' W. FROM THE NE COR. SEC. 6.

FINAL PROOF SURVEY

UNDER

Application No. G-10651 Permit No. G 9878
IN NAME OF

GILBERT L. AND ANNA C. BOYER

Surveyed 8-21, 1991, by J. MILLER