


T. 35 S., R. 5 W., W.M.

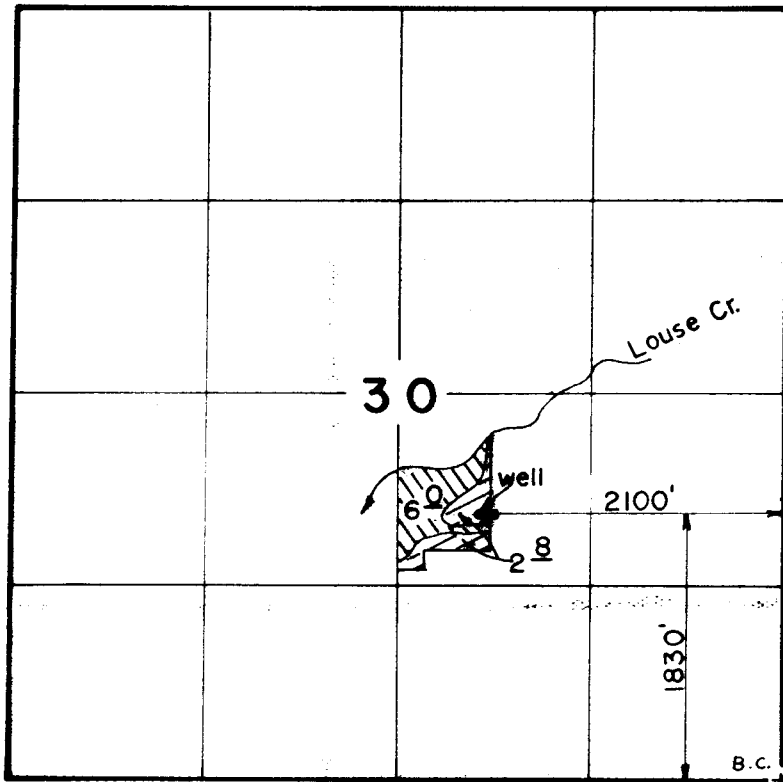

Scale: 1" = 1320'

RECEIVED

MAR 28 1990

W.D. DIST. 14
GRANTS PASS, ORE.

FINAL PROOF SURVEY
UNDER

Application No. G-10718 Permit No. G-9889
IN NAME OF

LAWRENCE J. & EMMA J. LENGWIN

Surveyed JUL. 30. 19.87., by B. S. JAMES.

41033-179-135R LML