

4200 19.19 A
5100
5200 19.02 A
5500 20.01 A
5300
5700 20.01 A

8-4

Application No. G-10798
Permit No. G 9903

4200
NO. 685

4600

4900

5000
20.01 A

5800
14.01 A

~~Application No. G-9171~~
~~Permit No. G 8727~~

RECEIVED

MAR 19 1979

WATER RESOURCES DEPT.
SALEM, OREGON

5900
9.50 Ac

5800

4600

26 25

Town ship 5 North

35

6800

6800

Range 28 East W. 36 31

Scale 1" = 1000'


6900
20.00 A



6400
19.01 A

6000
19.50 Ac

Area
To be Irrig.

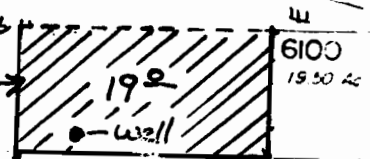

6100
19.50 Ac

8000

6700
40.01 A

6401
19.01 A

6401

6402
9.50 Ac

Well located 100' N and
350' East from Center
of sec. 36.

6200
9.50 Ac

RECEIVED

AUG 25 1982

WATER RESOURCES DEPT.
SALEM, OREGON

6401

6300
19.01 A

7500
4.75 A

45 30

6301
18.4 Ac
360 RD.

NO. 612

31

See Map 5N 29C