

RECEIVED


OCTO 6 1982

WATER RESOURCES DEPT.
SALEM, OREGON

T. 6S. R. 1W. W.M.

Application No. G-10824

Permit No. G 9910

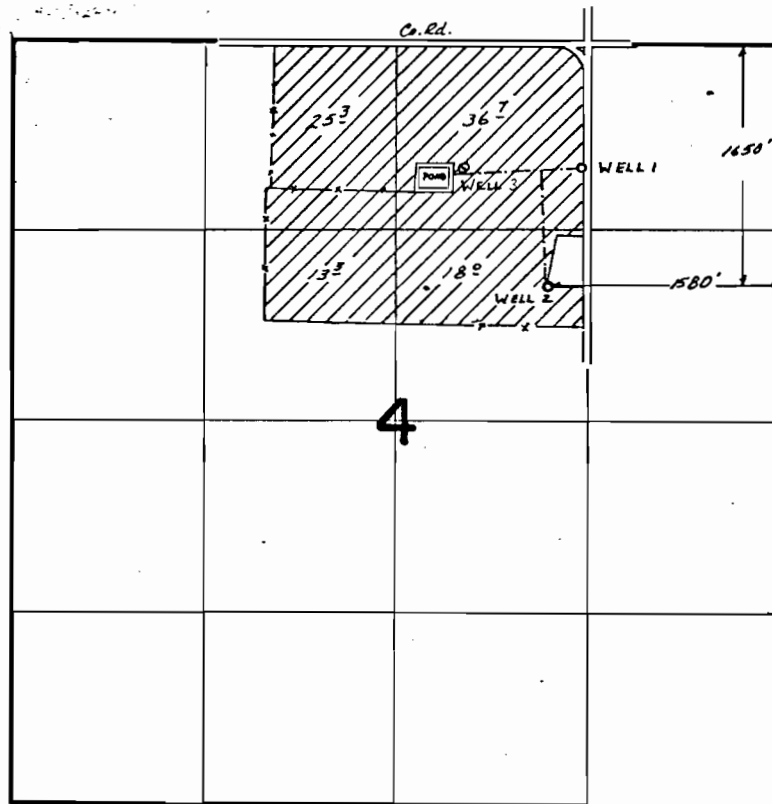

Well #3 Located: 850 feet south and 2160 feet West from
the NE corner Section 4