



EDMUNDSON

RAMOS

UNION

PACIFIC

RAILROAD
RIGHT-OF-WAY

WANDWATER
FIRE STATION

STATE HIGHWAY

TO PARKY LOCAL VALLEY

Application No. G-10649
Permit No. G 9912

LEGEND
WATERLINE WITH VALVE
FIRE HYDRANT

HIGH STREET

OWYHEE STREET

MAIN STREET

STREET

OREGON STREET

STREET

WASHINGTON STREET

STREET

FIFTH STREET

SNAKE RIVER

ADRIAN SCHOOL
DISTRICT NO. 61

HIGH SCHOOL

GRADE SCHOOL

ADRIAN SCHOOL
DISTRICT NO. 61

AMSTUTZ
BRANEY
HOLLY
BALDWIN
MCFADEN

WEBB
LINVILLE

PRESBYTERIAN
CHURCH

RIDFORD
BOWENS

MISLER
WILSON

MISLER
WILSON

SUTTON

WALKER

MILLER

DAUGHERTY
FIELD

WEIK

MAKLEY
DUBHEENT

DEWINS
STEPHENS

LOVIG
ROSENBAUM

BROWN
HAY

HOLLY
SLYKE
JONES

HOLLY
FOUNDS
DIETZ

ROBB
AMSTUTZ

ROBB
AMSTUTZ

ROBB
AMSTUTZ

LODOLY
THOMAS

RICE
WEBB

CARTWRIGHT
WADSWORTH
REEL

WEBB
RENNINGTON
FREEL

PARKER
WHITE

BRANNAN
SMITH
MARTIN

LOVETT
FREEL

FREEEL

FREEEL

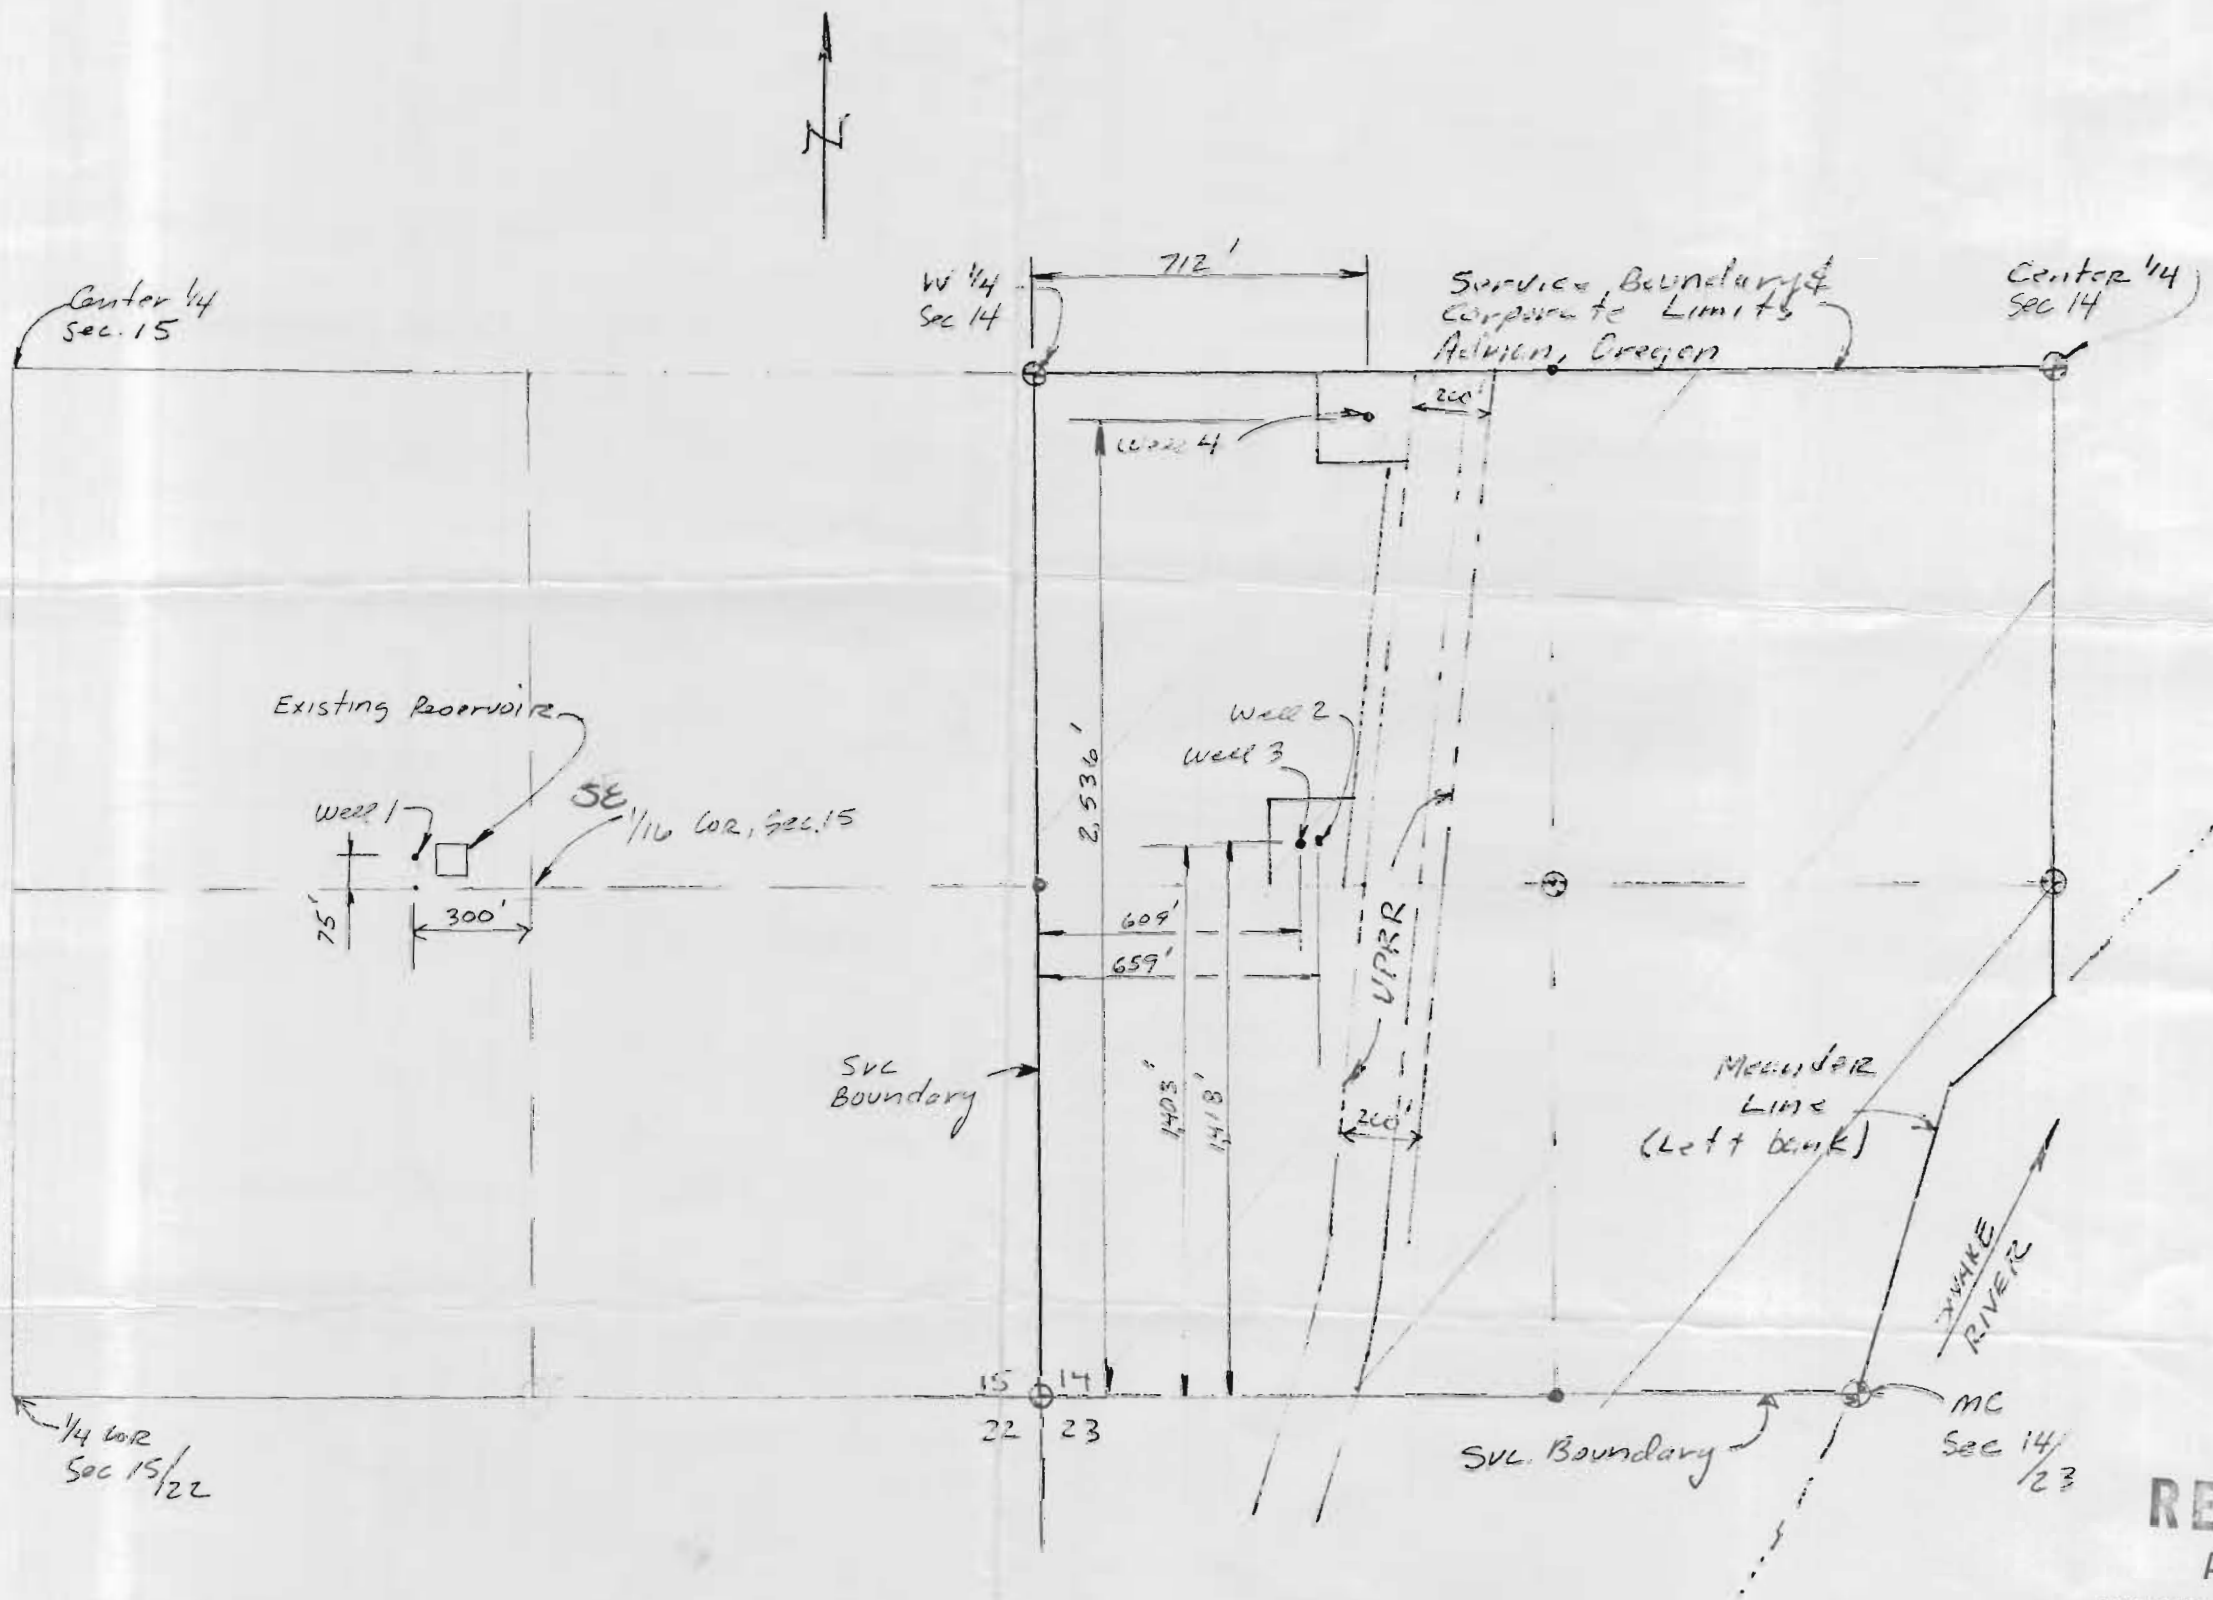

Application No. G-10619
Permit No. G 9912

RECEIVED
AUG 5 1982
WATER RESOURCES DEPT.
SALEM, OREGON

CITY OF ADRIAN
SW 1/4 Sec. 14 T.21S. R.46E. 10M
1"=500'