


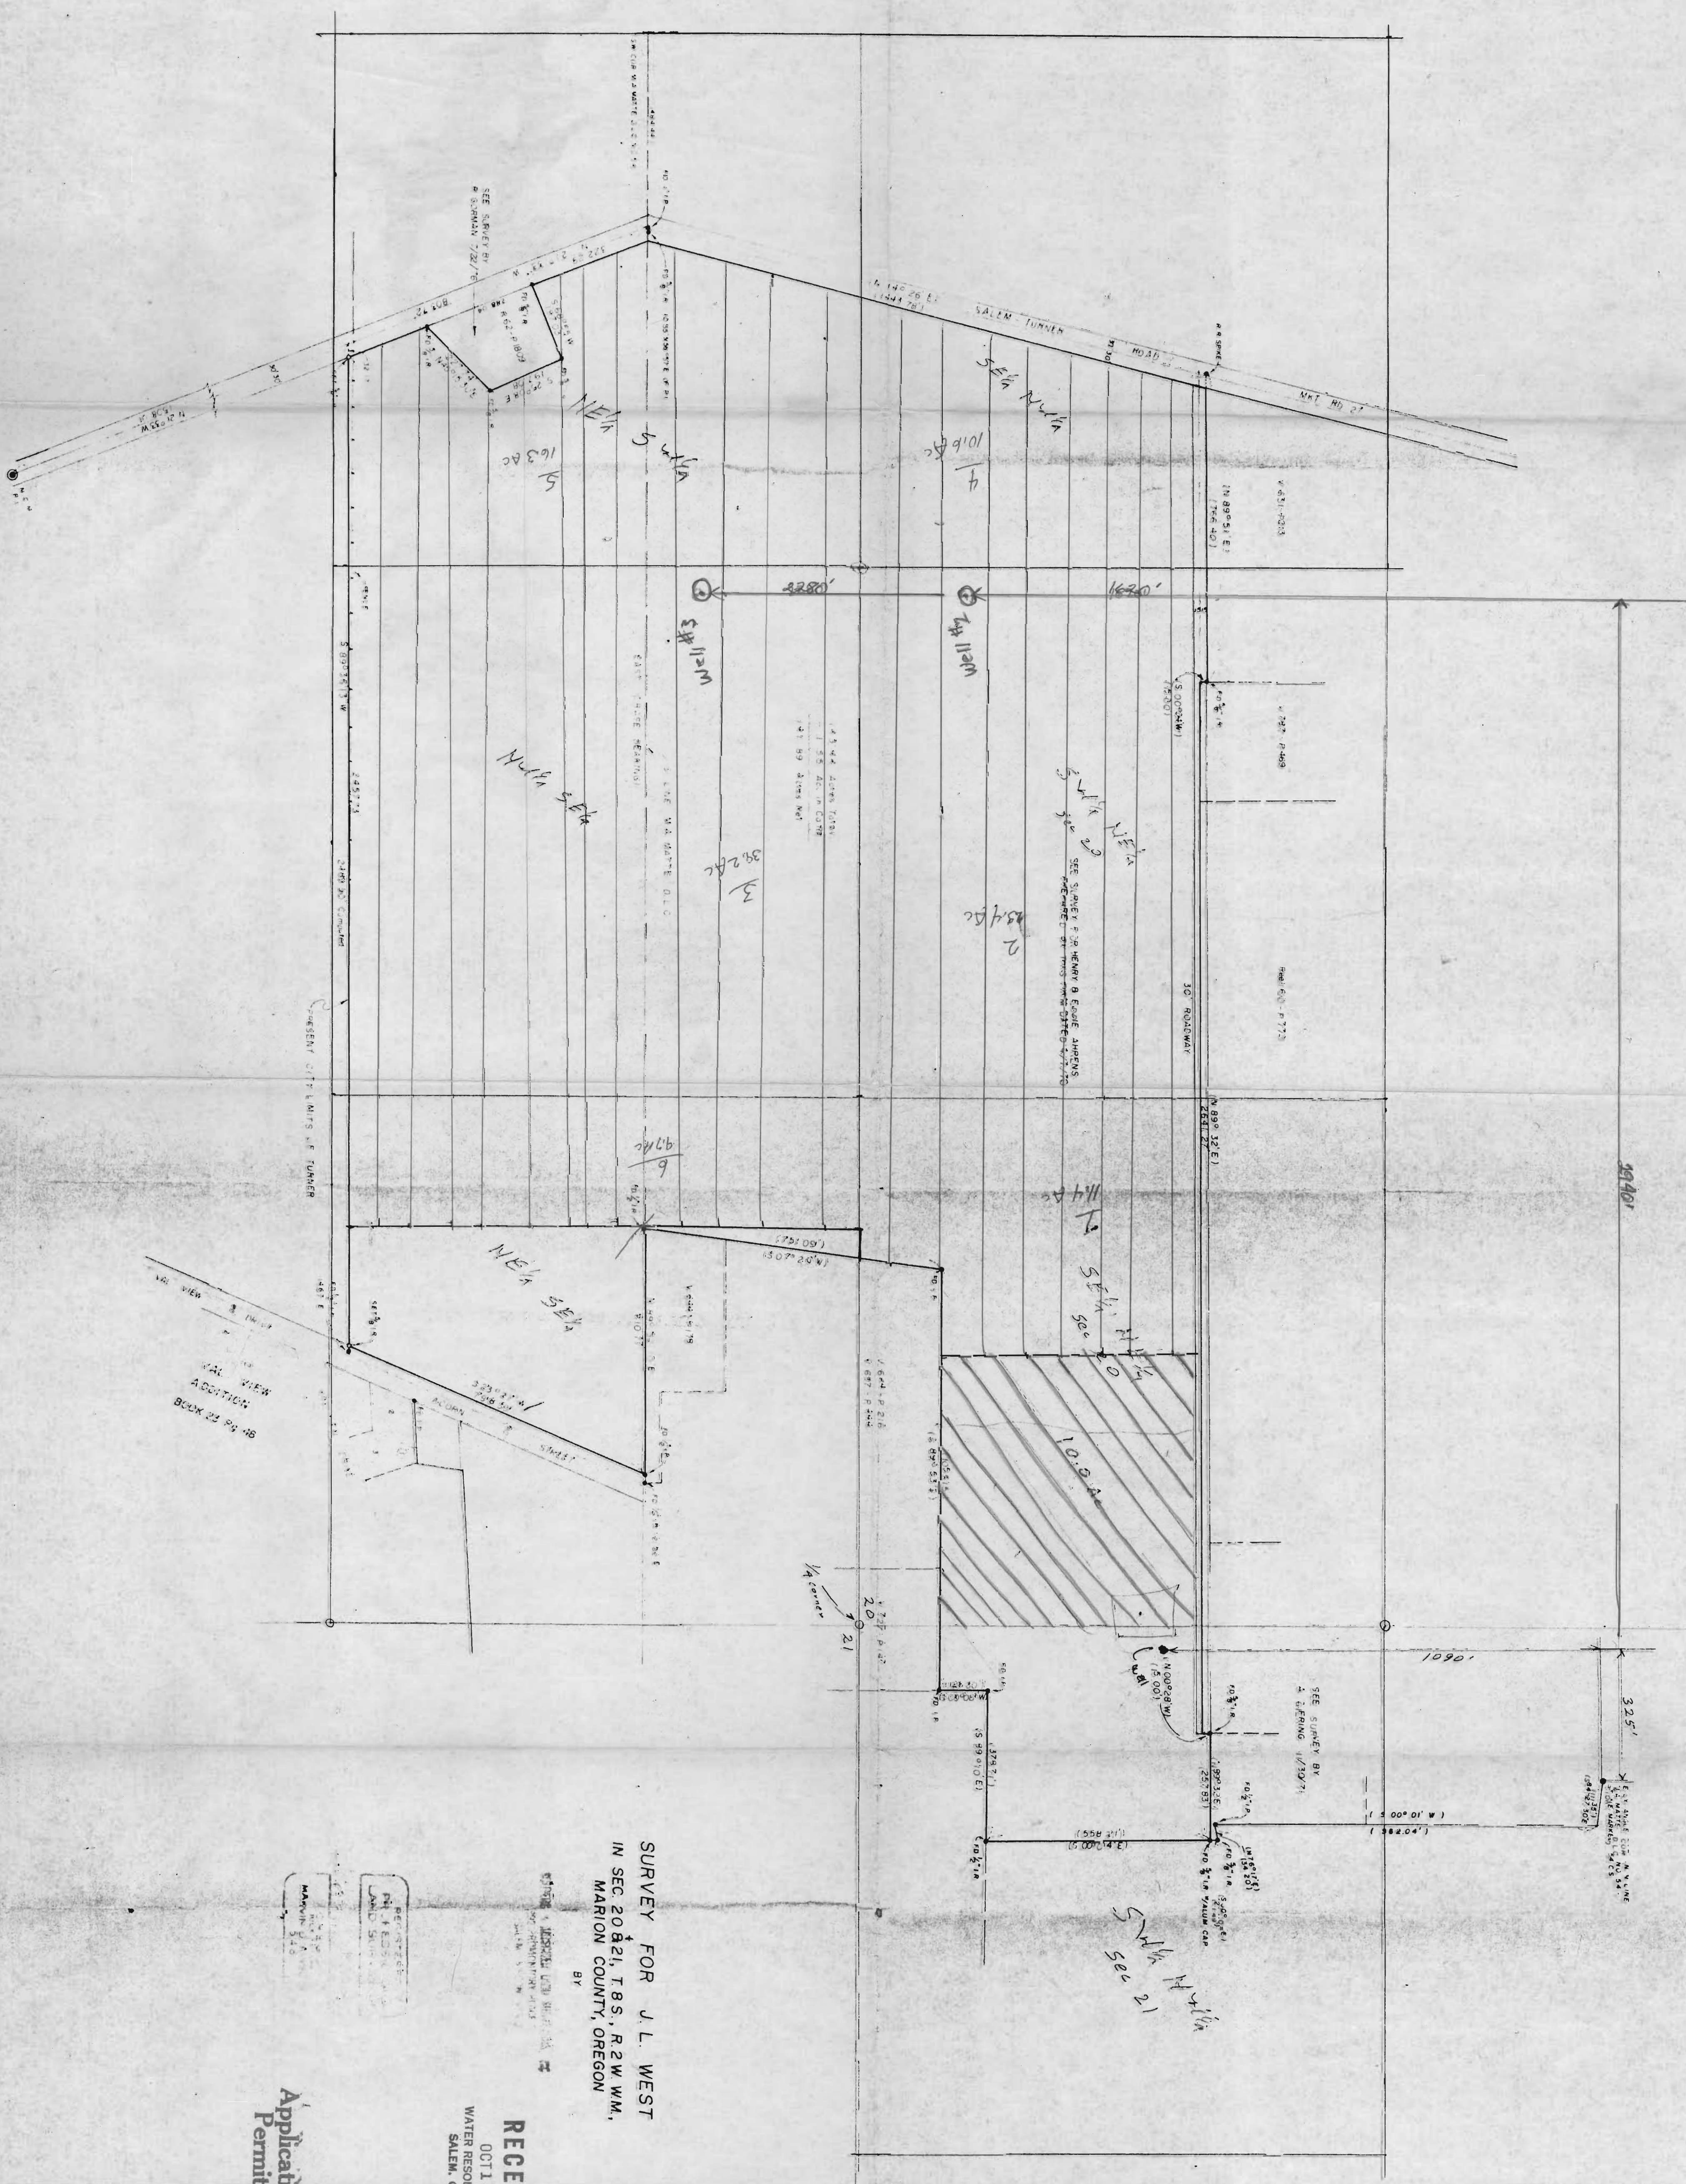

SURVEY FOR J.L. WEST
IN SEC. 20 & 21, T.8S., R.2W. W.M.,
MARION COUNTY, OREGON


RECEIVED
OCT 14 1982
WATER RESOURCES DEPT.
SALEM, OREGON

Application No. G-10701
Permit No. G 9927

MONUMENTS:
• - FOUND





Lands to be irrigated from well #1

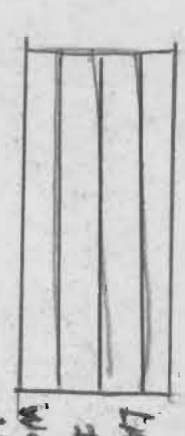


Lands to be irrigated from wells #2 & #3 through a common system

SCALE: 1" = 200'

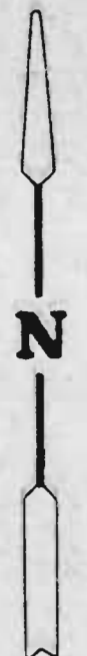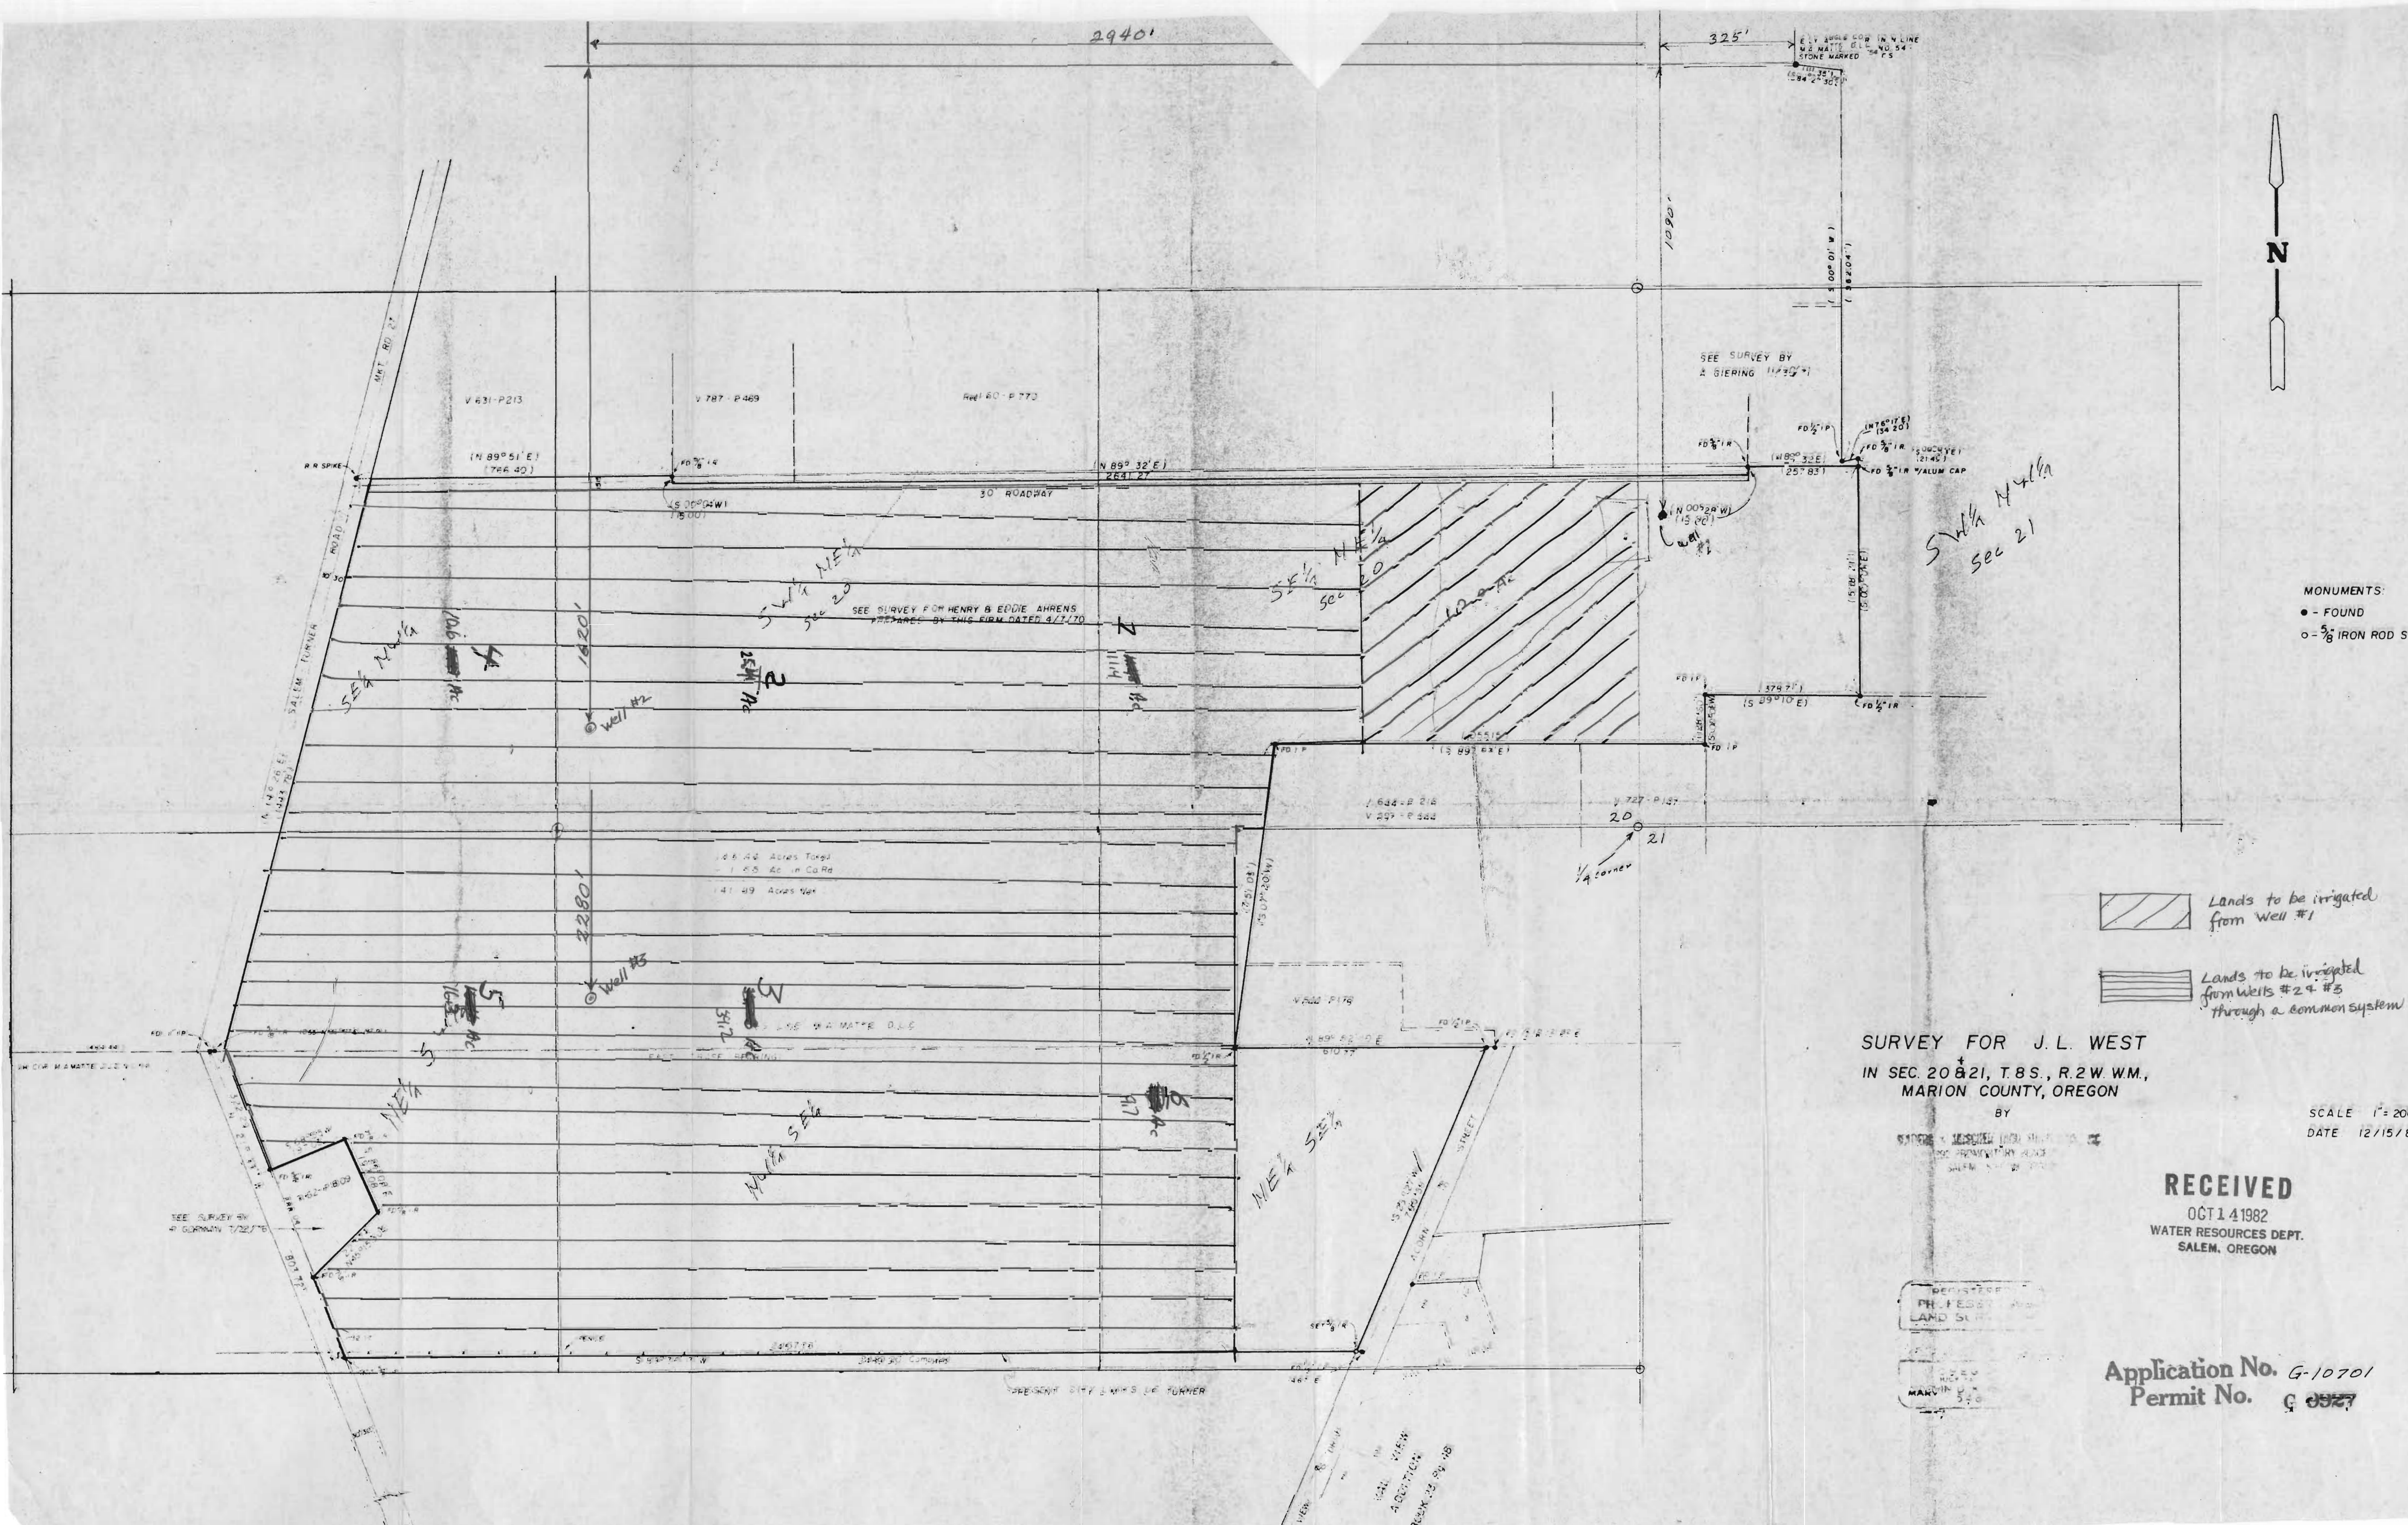

MONUMENTS:
• - FOUND
○ - 5/8" IRON ROD SET

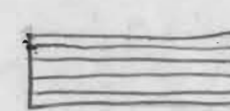 Lands to be irrigated from Well #1
 Lands to be irrigated from Wells #2 & #3 through a common system

SURVEY FOR J.L. WEST
IN SEC. 20 & 21, T.8S., R.2W. WM.,
MARION COUNTY, OREGON
BY

SCALE 1" = 200'
DATE 12/15/80

RECEIVED
OCT 14 1982
WATER RESOURCES DEPT.
SALEM, OREGON

Application No. G-10701
