

RECEIVED

NOV 18 1982

WATER RESOURCES DEPT.
SALEM, OREGON

RECEIVED


JUN 3 - 1982

WATER RESOURCES DEPT.
SALEM, OREGON



Application No. G-10839

Permit No. G 9944

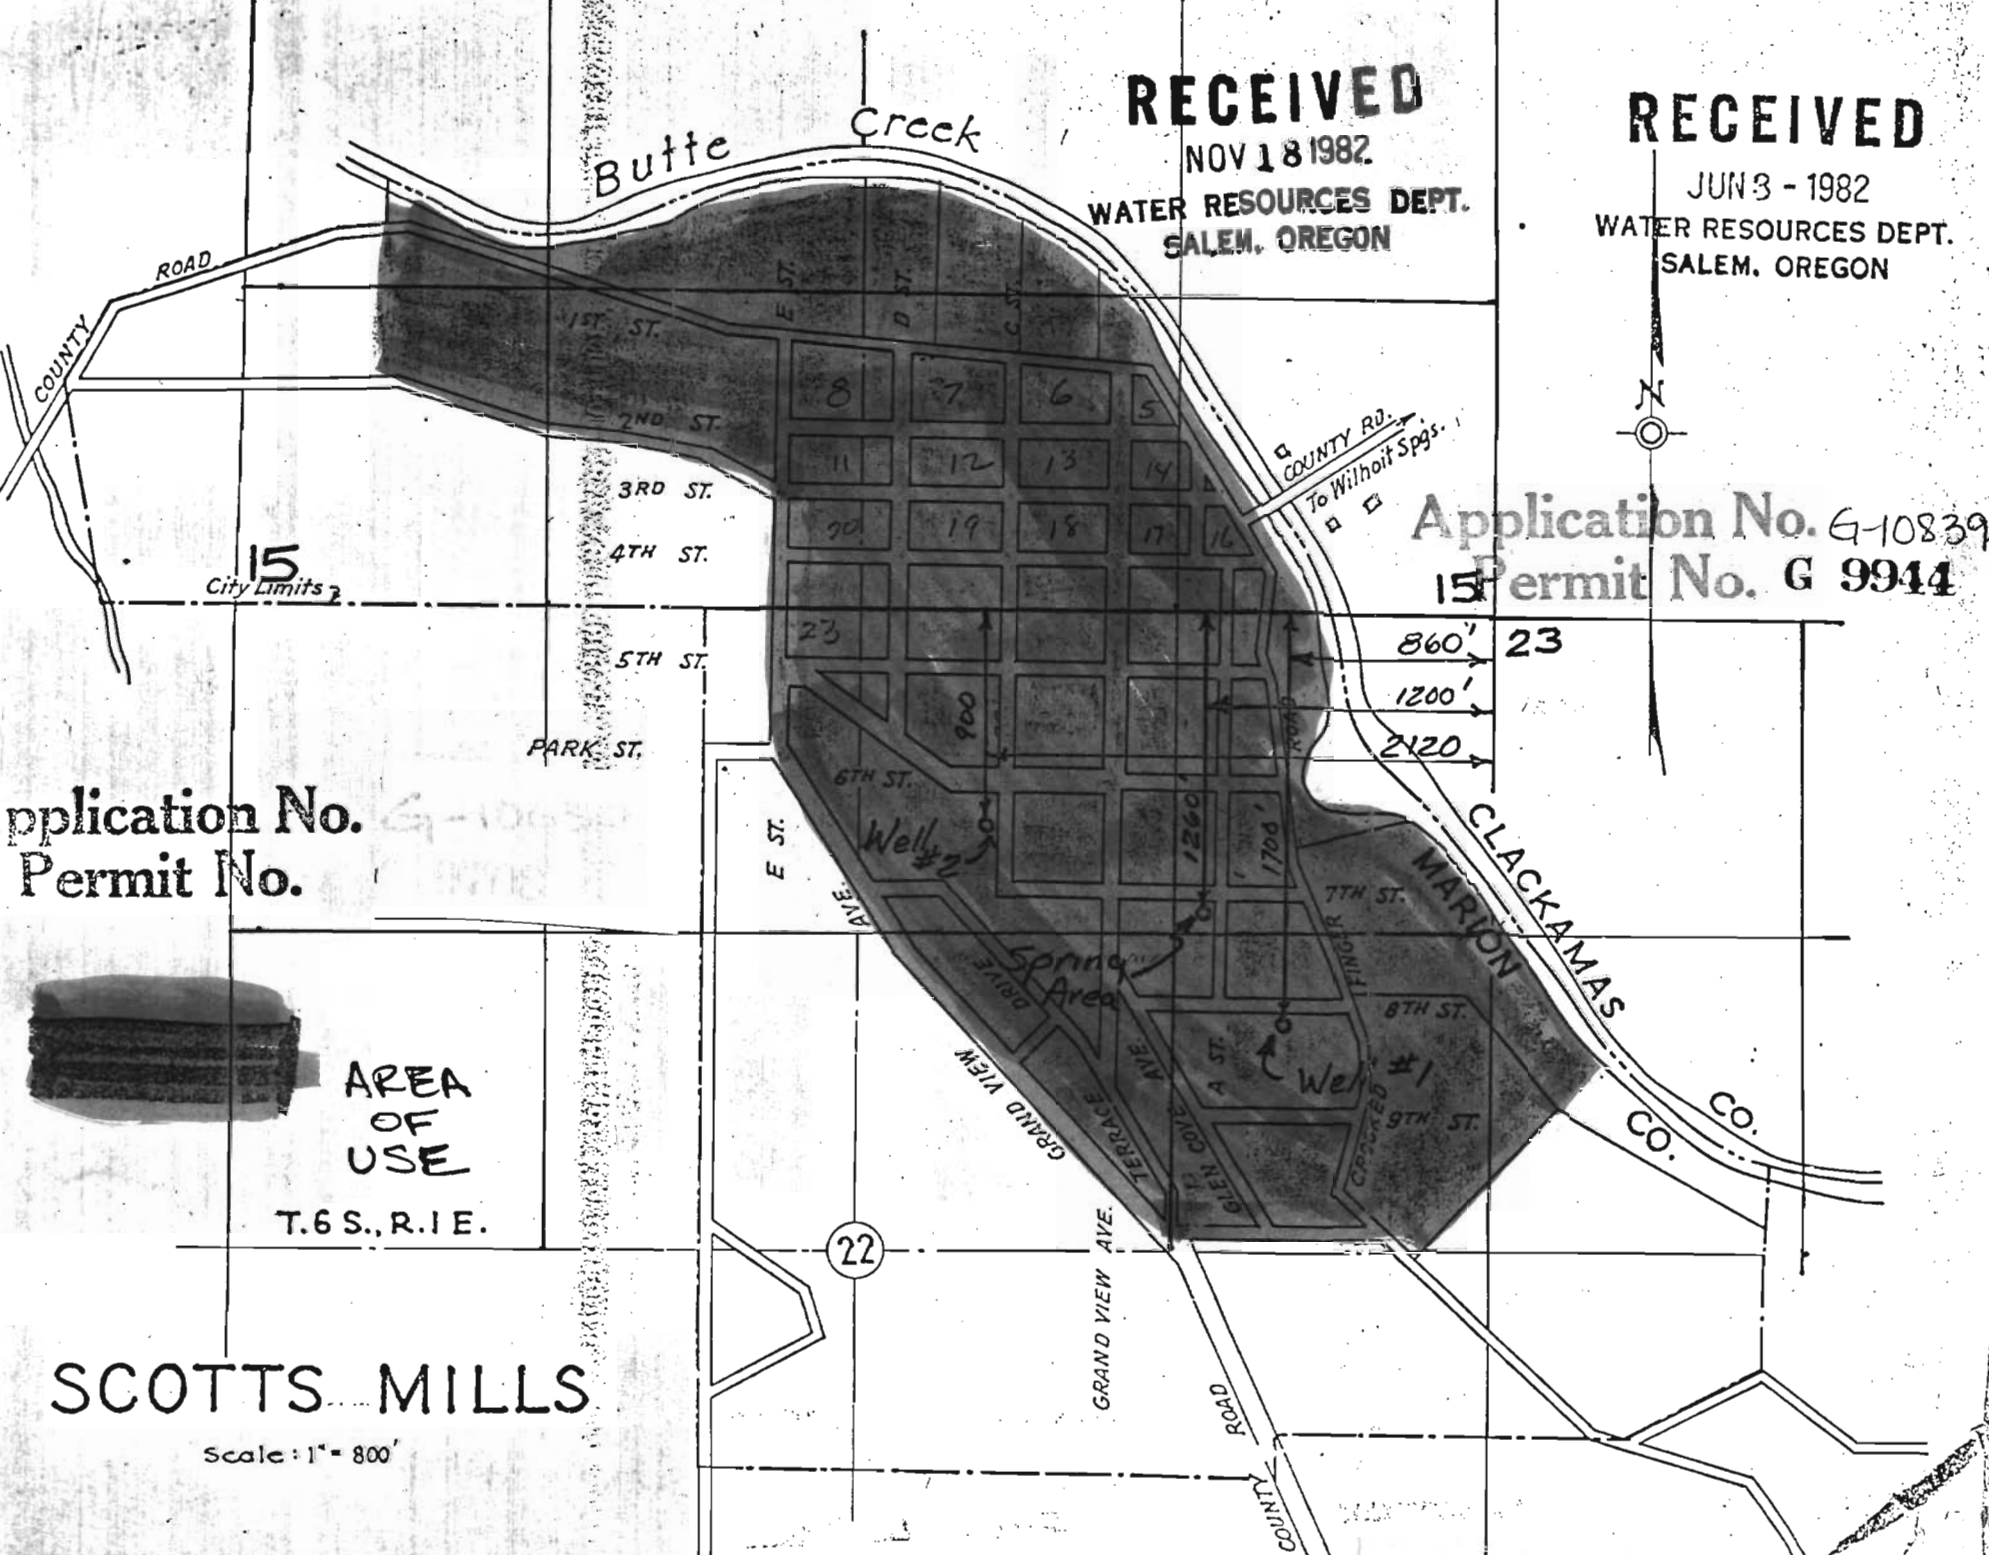

Application No. G-10839
Permit No. G 9944

AREA
OF
USE

T.6 S., R.1 E.

SCOTTS MILLS

Scale: 1" = 800'