


Application No. G-10850
 Permit No.

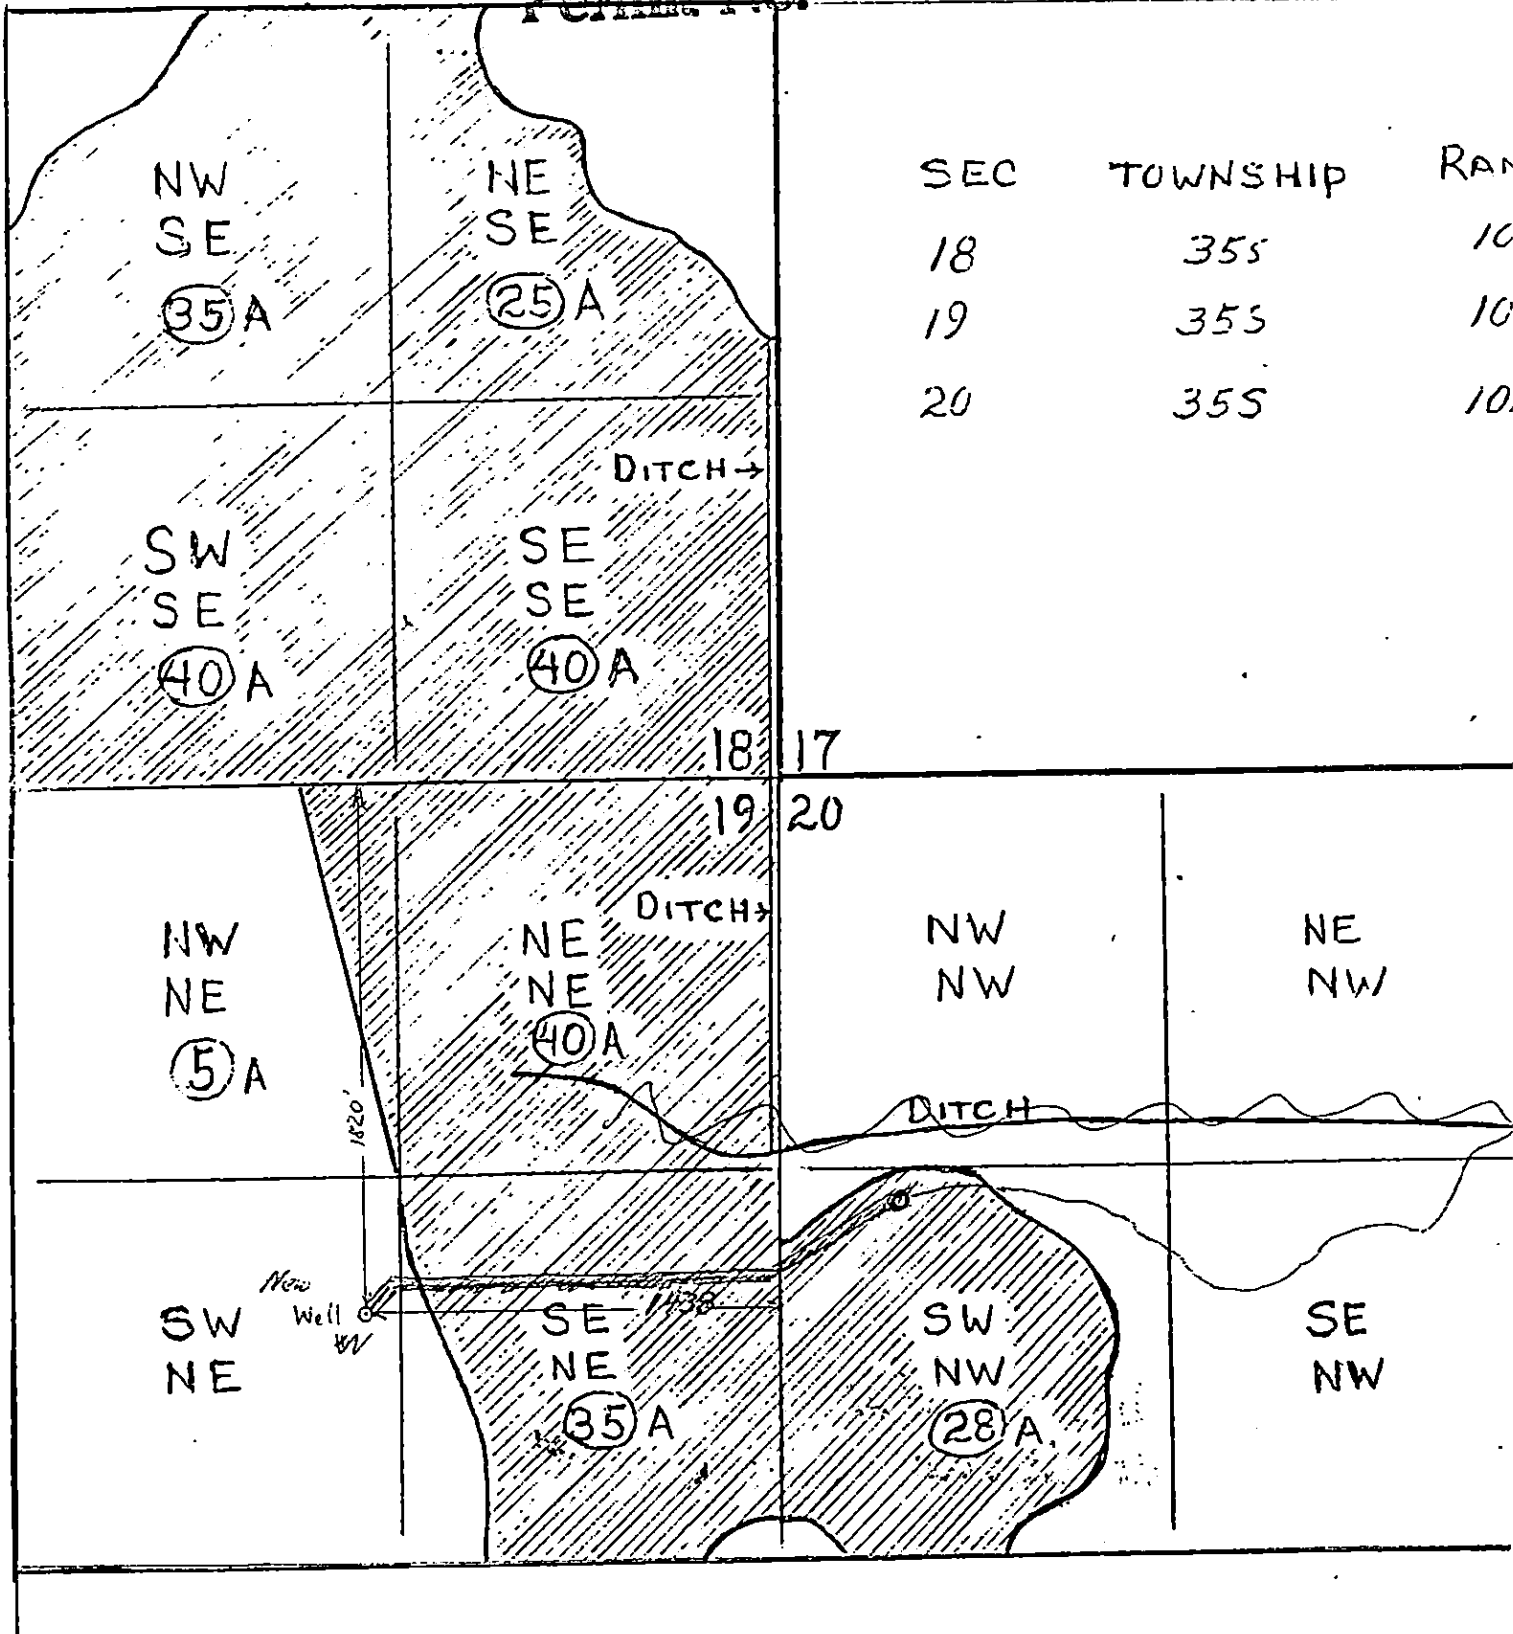

SEC	TOWNSHIP	RANGE
18	35S	10
19	35S	10
20	35S	10

Grant F Brown & Fred

Application No. ~~G-10488~~


Permit No. ~~G-9661~~

RECEIVED

AUG 8 1991

WATER RESOURCES DEPT.
SALEM, OREGON

T.35S. R.10E.W.M.

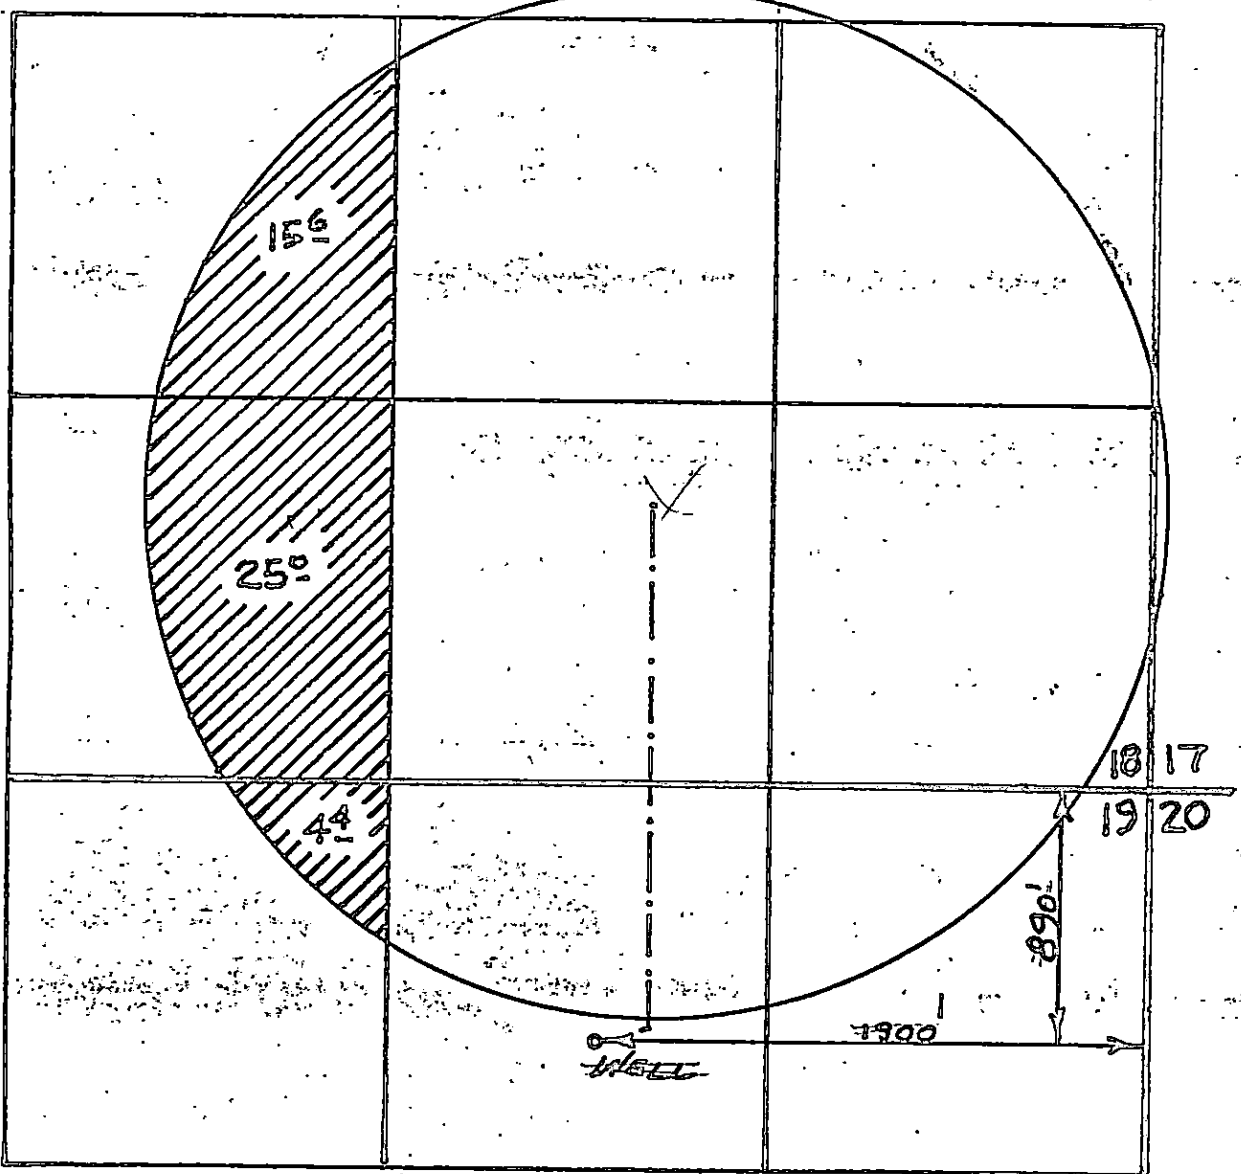

SCALE: 8" = 1 MI.

Application No. G-10850

Permit No. G 9963

RECEIVED

DEC-6 1982

WATER RESOURCES DEPT.
SALEM, OREGON