


T.17 & 18 S., R.13 E., W.M.

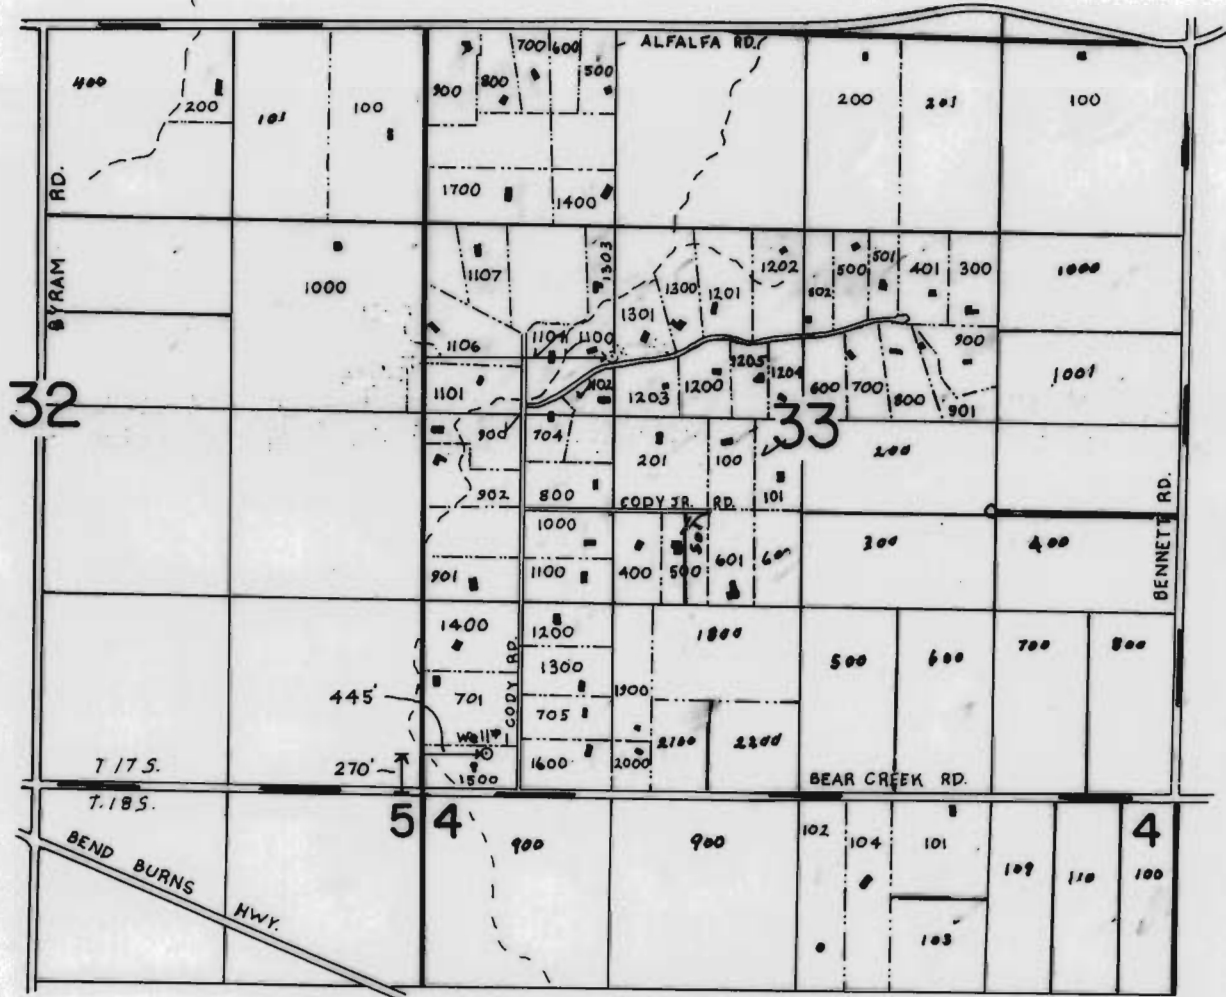

SCALE: 1" = 1320'

FINAL PROOF SURVEY UNDER

Application No. G-10347 Permit No. G-11972
IN NAME OF

AVION WATER CO., INC.

Surveyed APRIL 11 1996, by R.M. SUTTERFIELD

CORRECTED 10-09-2006 JS
DRAFTED 10-31-96 by R.M.S