


T. 25S. R. 5W.

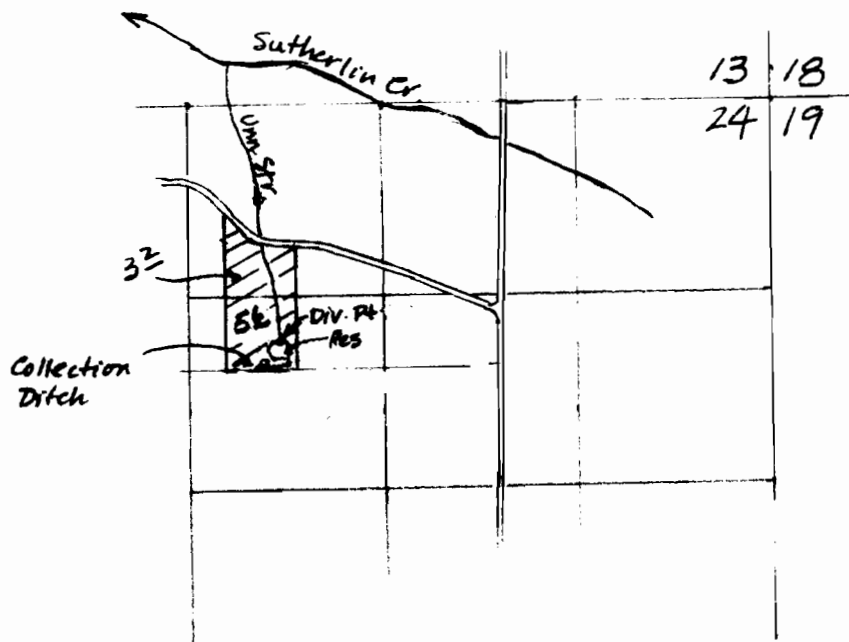

Scale: 4" = 1 mile

DIV. PT. 1620' S. and 3350' W
from NE Cor. Sec. 24

RECEIVED

AUG 13 1984

WATER RESOURCES DEPT
SALEM, OREGON

RECEIVED

JUL 2 1984

WATER RESOURCES DEPT
SALEM, OREGON

Application No. R-68112 & 68113
Permit No. R10051 48992

RECEIVED

NOV 7 1984

WATER RESOURCES DEPT.
SALEM, OREGON