


T10S R35E Sec 1

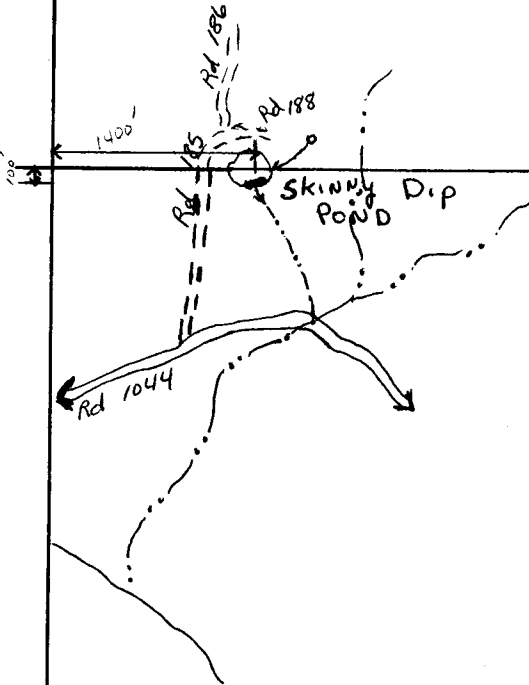

R64247

Application No.
Permit No.
R10084
RECEIVED

SEP 1 1983
WATER RESOURCES DEPT.
SALEM, OREGON

4" = 1 mile

