


RECEIVED

OCT 4 1984

WATER RESOURCES DEPT
SALEM, OREGON

T. 30S. R. 4W.

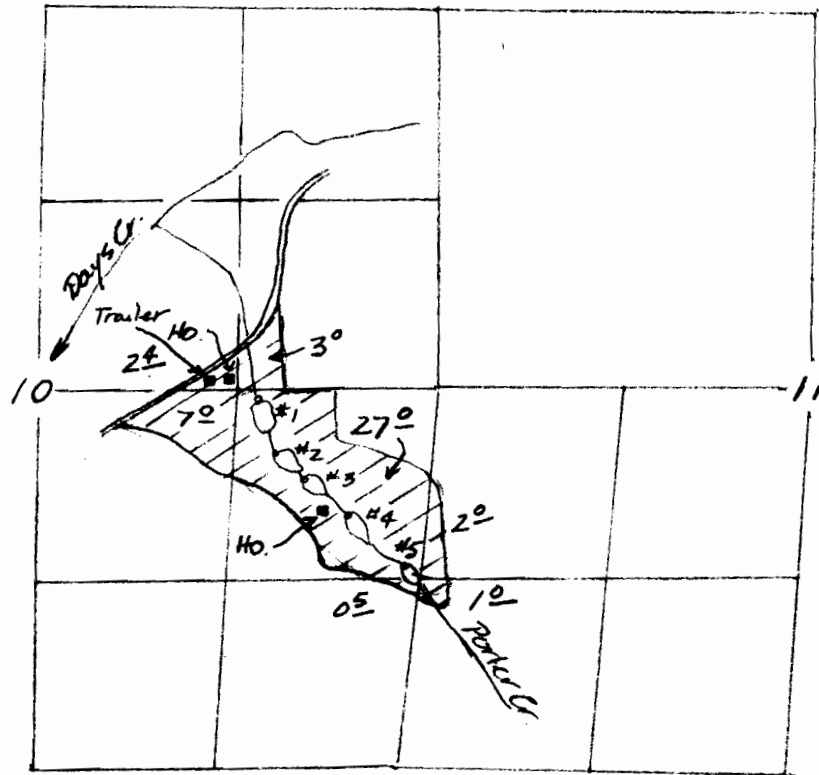

Div. Pts located from E $\frac{1}{4}$ Cor Sec 10:

- #1: 70' S. and 1250' W.
- #2: 450' S. and 1100' W.
- #3: 620' S. and 900' W.
- #4: 860' S. and 600' W.
- #5: 1200' S. and 200' W.

RECEIVED

Application No: 68125, R-68193 JUL 20 1984

Permit No. 49184

R10825

WATER RESOURCES DEPT
SALEM, OREGON