

RECEIVED

FEB 22 1984
WATER RESOURCES DEPT.
SALEM, OREGON


Application No.
Permit No.

R-68348, 68349 & G-11384
R10587
49555 G10542

RECEIVED

MAY 1 1985
WATER RESOURCES DEPT
SALEM, OREGON

T285 R14W

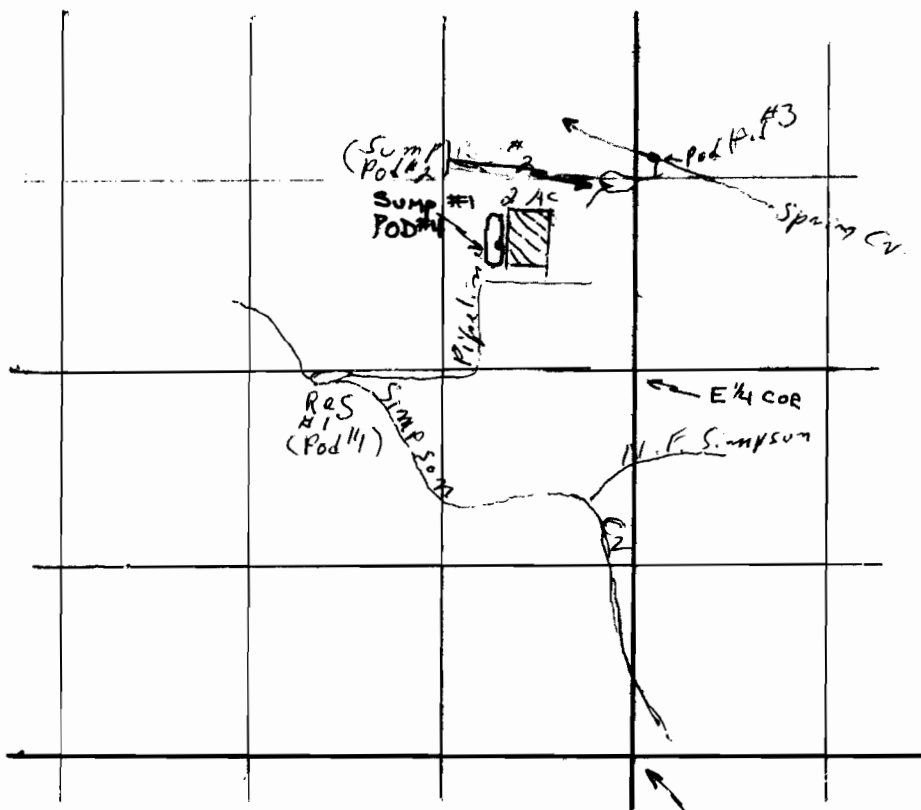

RES #1, Pod 15 70'S 2240'W From E 1/4 cor Sec 20
 Spring CV, Pod 15 1439'N 98'E From E 1/4 cor Sec 20
 Sump #1, Pod 15 1319'N 244'W From E 1/4 Corn. Sec 20
 Sump #1, Pod #4 860'N, 940'W From E 1/4 Corn. Sec 20

20/21
29/28

RECEIVED

OCT 11 1985
WATER RESOURCES DEPT
SALEM, OREGON