


T. 1 N., R. 2 W., W.M.

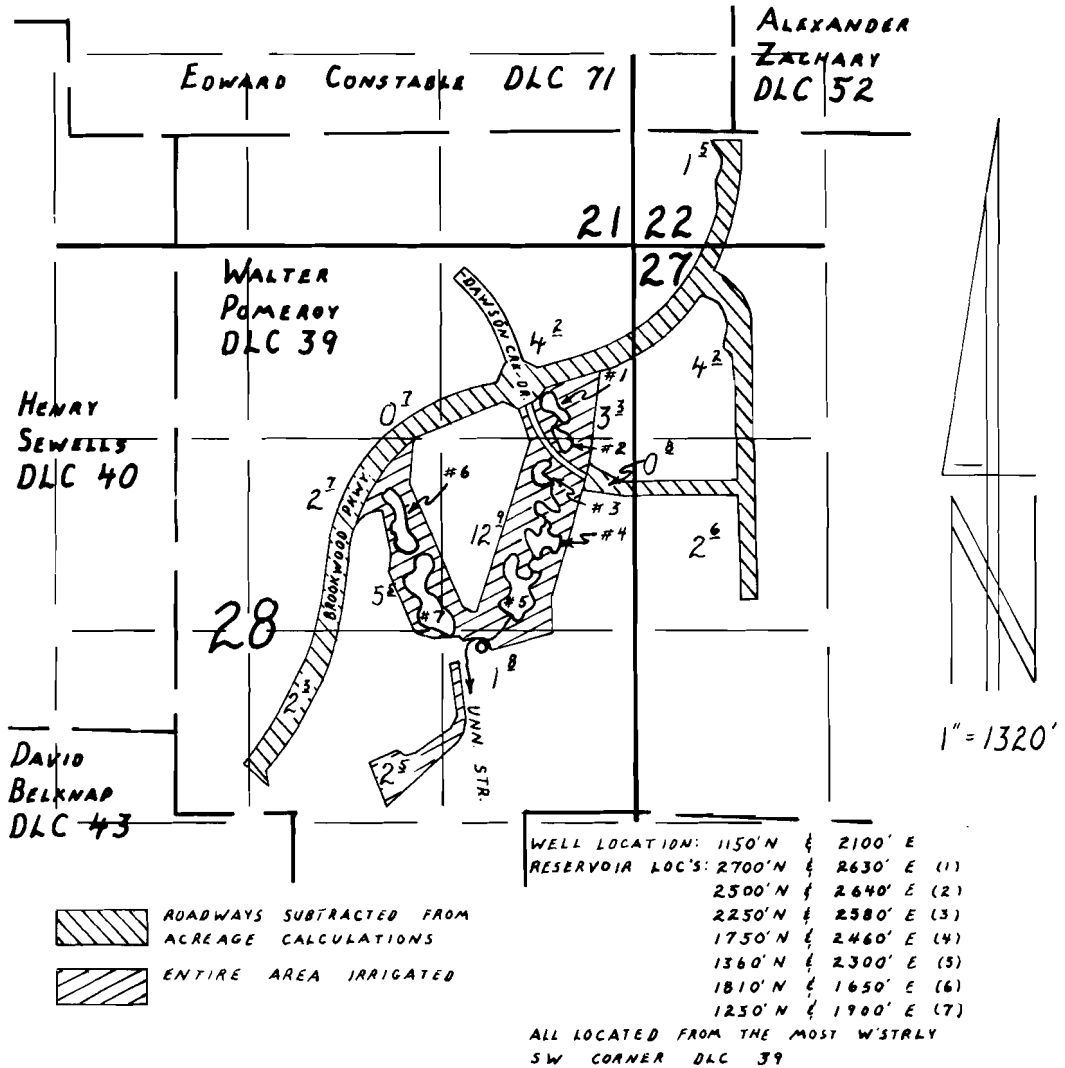

FINAL PROOF SURVEY

UNDER

Application No. G-11520, R-68729, 68730 Permit No. G-10819, R-10624, 49674
IN NAME OF

Dawson Creek Park, Inc.

Surveyed July 15, 1993, by R.W. Klassen