T. 2 & 3 S., R. 3 E., W.M.

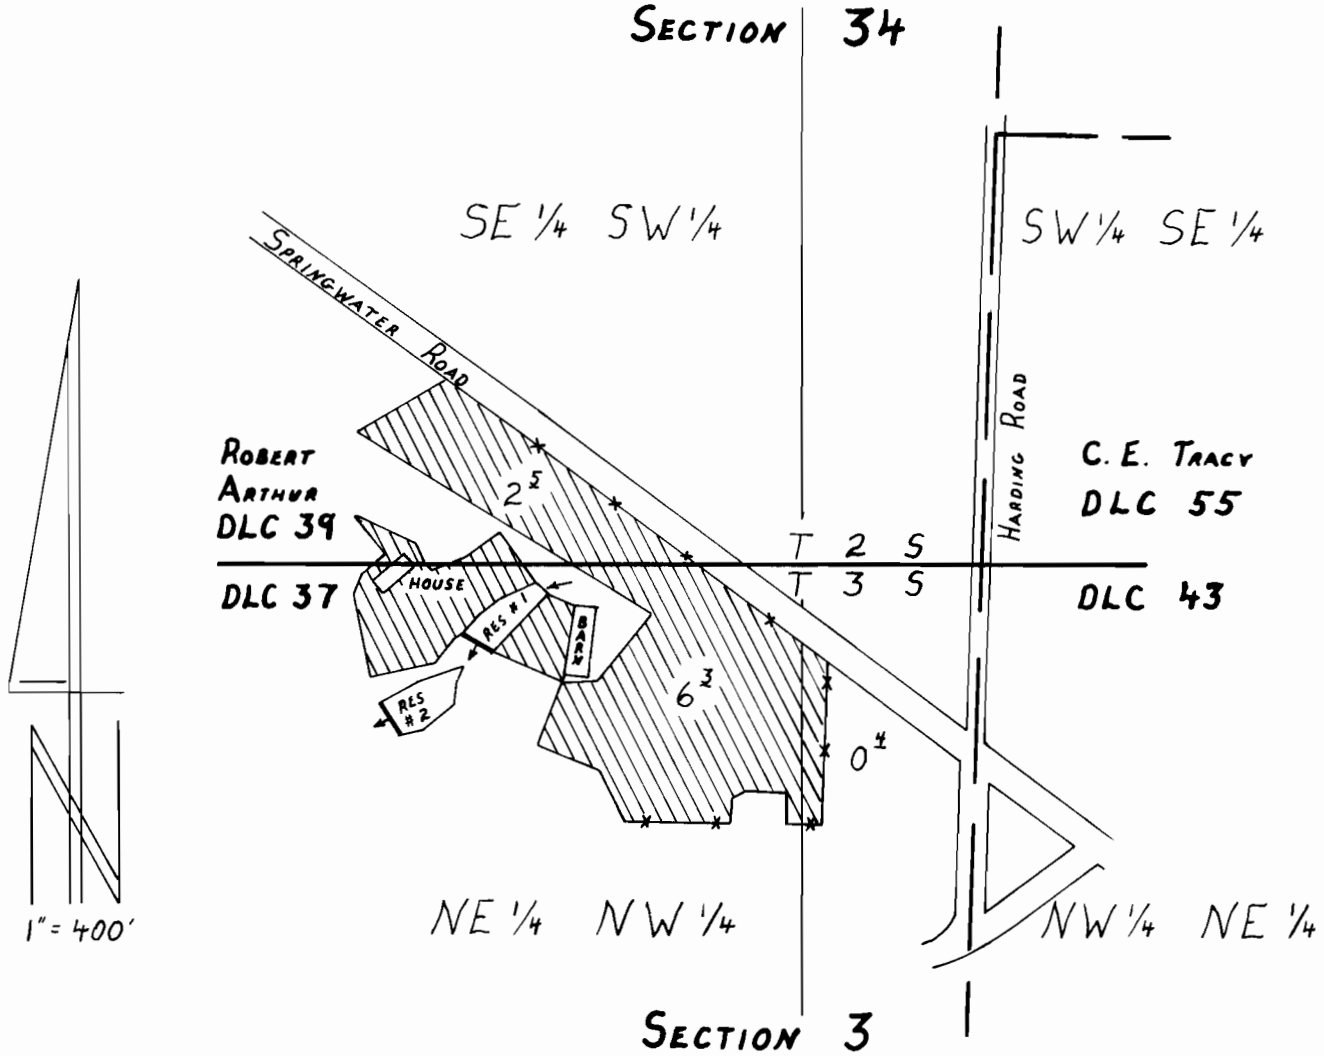

FINAL PROOF SURVEY

UNDER

R-69027 R-10831

Application No. 69028 Permit No. 50029

IN NAME OF

LAMONT L. & DOREEN R. RUMGAY

Surveyed MAY 14, 1992, by R.W. Klassen

PTS W/FF RWK 2/93