


I. 25. R. 4 E W. 111
 Scale 4" = 1 mile

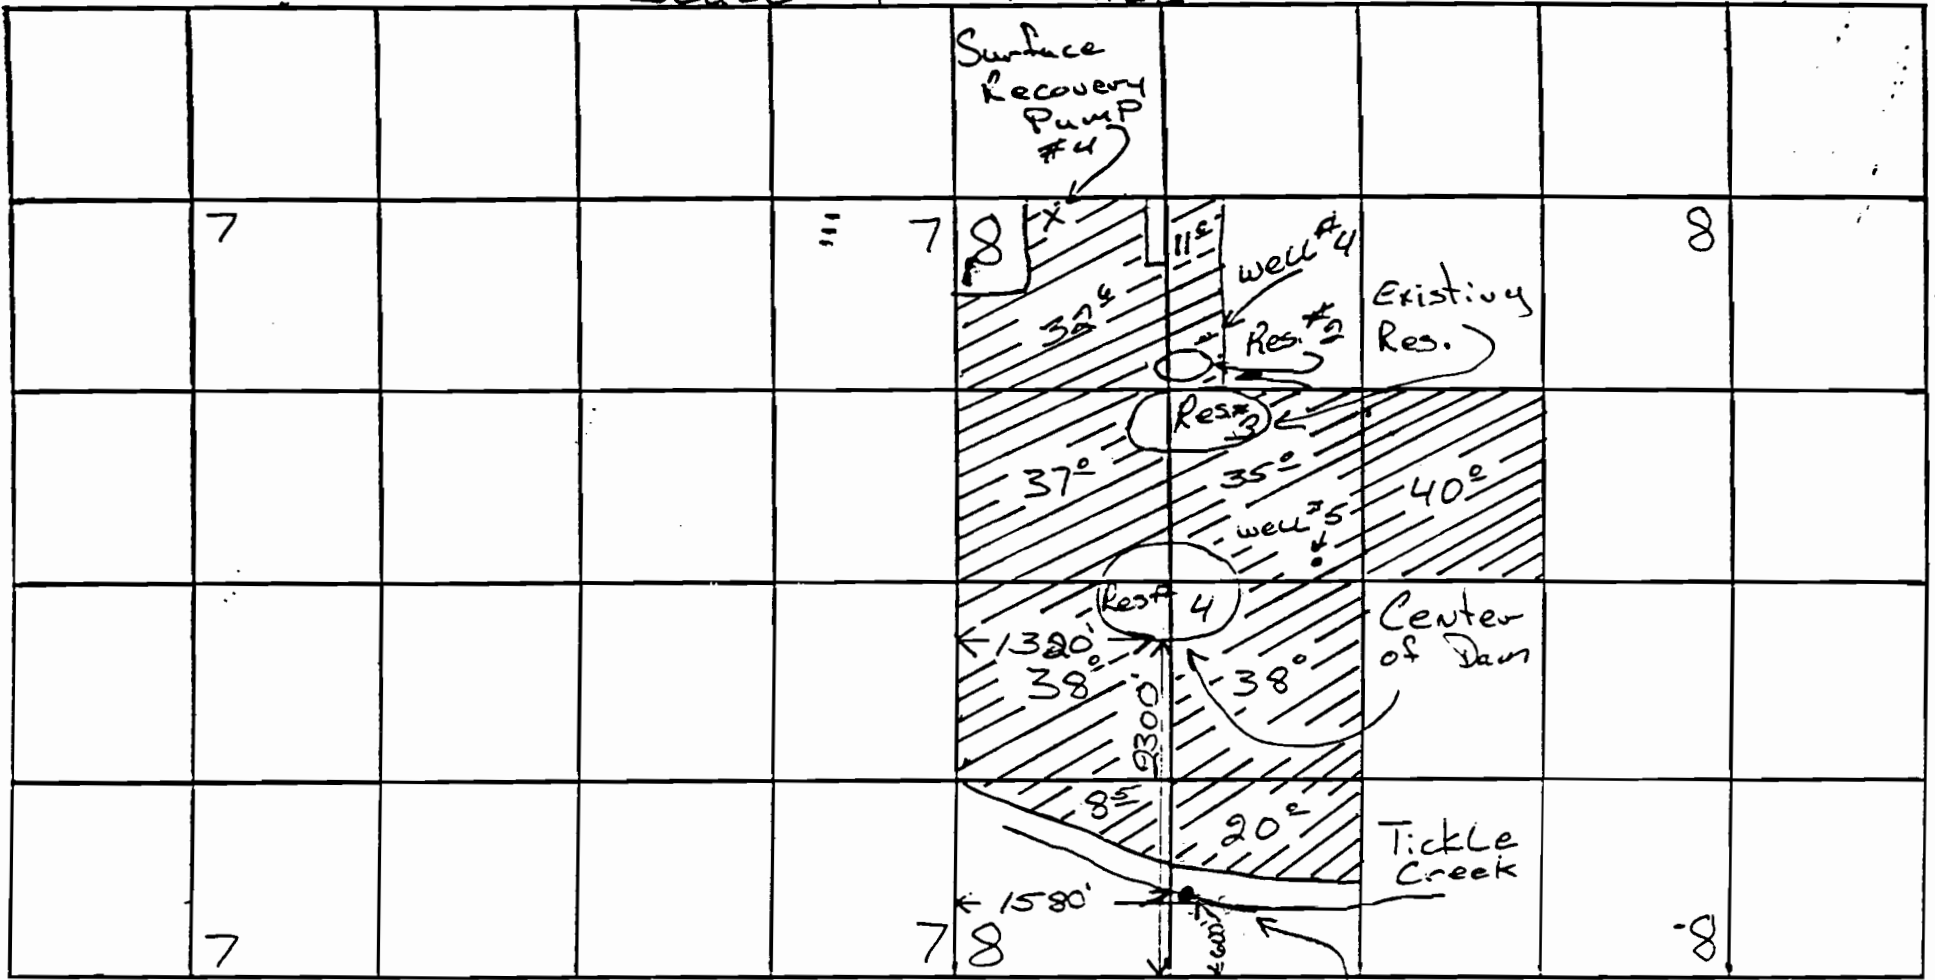

Div. AT Tickle Creek
 600' N & 1580' E. From S.W. Corner
 Sec. 2 T2E, R4E

Diversiou Point

Application No. R-69175 & 69176
 Permit No. R10837 50048