

R. 5 W.


RECEIVED  
OCT 22 1969

STATE ENGINEER  
SALEM, OREGON

RECEIVED

DEC 24 1987

WATER RESOURCES DEPT.  
SALEM, OREGON

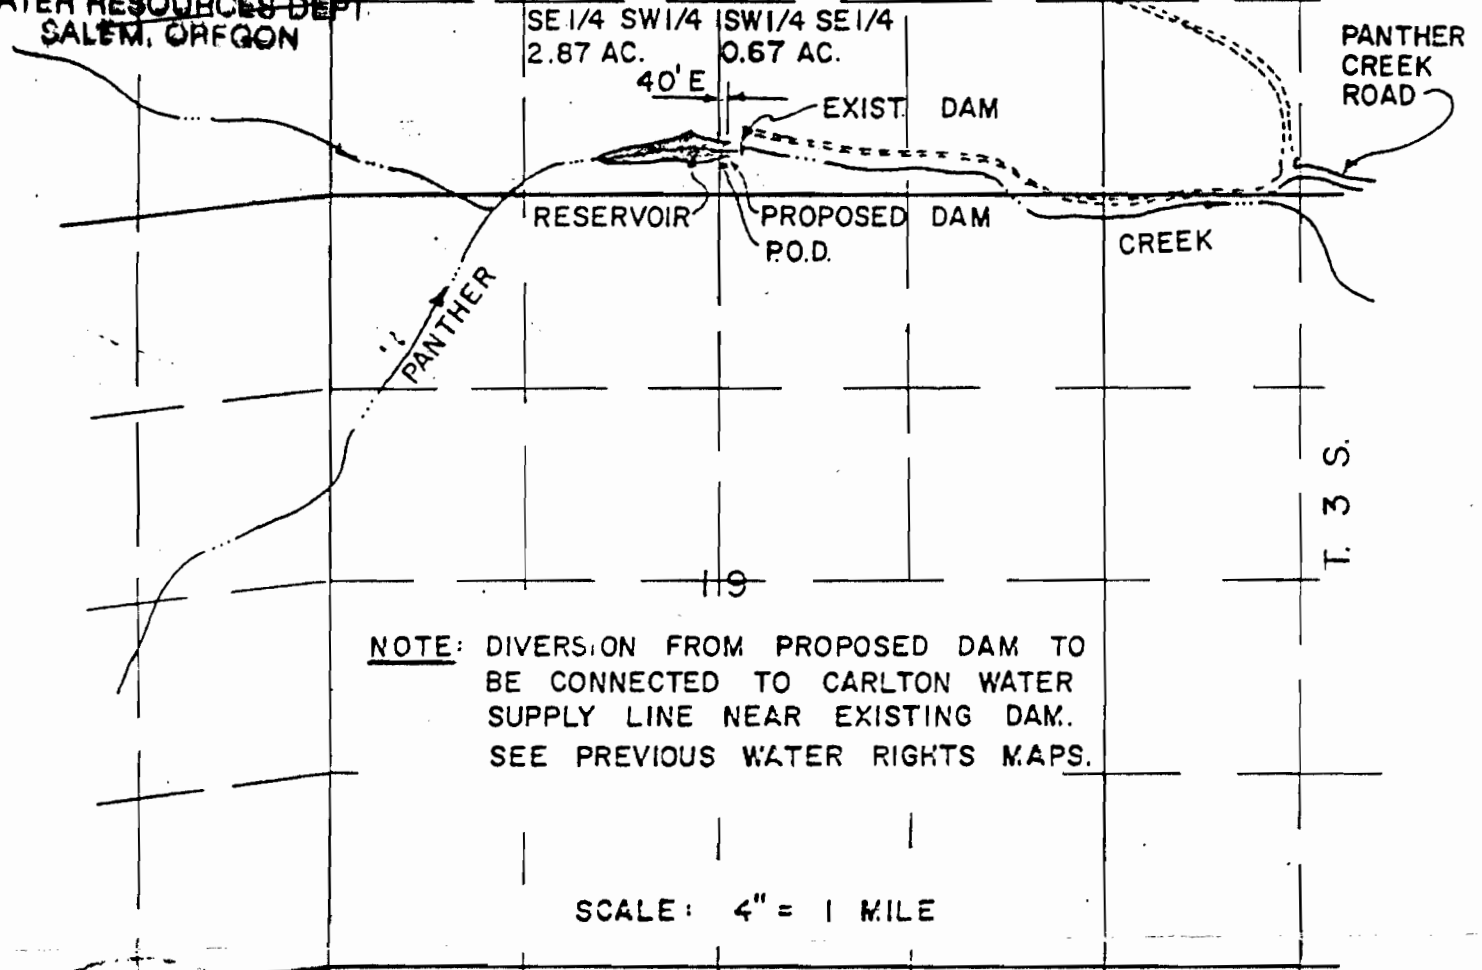

NOTE: DIVERSION FROM PROPOSED DAM TO  
BE CONNECTED TO CARLTON WATER  
SUPPLY LINE NEAR EXISTING DAM.  
SEE PREVIOUS WATER RIGHTS MAPS.

SCALE: 4" = 1 MILE



WATER RIGHTS MAP

APPLICATION NOS. \_\_\_\_\_

FOR

CITY OF CARLTON

BY

WESTECH ENGINEERING, INC.

Application No. ~~R-46504~~ ~~NO. 6505~~

Permit No. ~~24661~~

OCTOBER, 1969

POINT OF DIVERSION VERIFIED  
BY A.M. KLEIN, P.E.  
DECEMBER 23, 1987

APPLICATION NO.  
R-69512 & 69513

BY A.M. KLEIN

Application No. R-69512 & 69513  
Permit No. R10900 50218

THIS MAP WAS PREPARED FOR THE  
PURPOSE OF THE LOCATION OF A WATER  
RIGHT POINT OF DIVERSION AND IS NOT  
INTENDED TO PROVIDE DIMENSIONS OR  
THE LOCATION OF PROPERTY LINES.  
THIS WORK WAS PERFORMED UNDER MY  
DIRECT SUPERVISION.

R. CHARLES PEARSON, W.R.E.  
ANDY KLEIN AND ASSOCIATES  
1928 COUNCIL ST.  
FOREST GROVE, OR 97116

12/23/87

