

SECTION 22, TWP.1 N. RANGE 12 E. W.M. WASCO COUNTY, OREGON

C.1/4 COR.
SEC. 22.

W.1/4 COR.
SEC. 22.

TAX LOT 100



CERTIFICATE 5685, T-5992,
PRIORITY 1861.



CERTIFICATE 7110, T-5993,
PRIORITY JULY 23, 1923.



NEW LAND, AUG. 4, 1987, PERMIT
50802, 0.8 AC. RECREATION POND.

ALL AREAS SUPPLEMENTAL USE UNDER
G-10940 INCLUDING POND.

N.E.1/4, S.W.1/4

5.2 AC.

DOMESTIC WATER

10' PAVED
DRIVEWAY

ROAD

CREEK

HOUSE

0.82 AC.

8' DEPTH 10 AC./FT.
PERMIT R-1187
RECREATION POND
1500' N. & 450' W.
OF S.1/4, SEC. 22
SPRING AREA LOCATED
IN POND AREA.

WELL 1280' N. & 640' W.
OF S.1/4, SEC. 22,
PERMIT G-10940

PUMP, 830' N. & 780' W.
OF S.1/4, SEC. 22

S.E.1/4, S.W.1/4

7.1 AC.

TAX LOT 400

TAX LOT 500

1N-12-22C

CLD DIV. PT.
CERT. 5685

OLD DIV. PT.
CERT. 7110

1/16 COR.

T.L. 300

T.L. 300

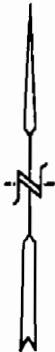

21 22
26 27

S.1/4, SEC. 22,
FD. BRASS CAP
M.W. ON L.P.

FINAL PROOF SURVEY

SCALE: 1" = 400'


TRANSFER AND
CERTIFICATE No. T-5992 & T-5993

PERMIT No. 50802, R-11187 & G-10940

IN THE NAME OF:
W. JAY HOFFMAN

DATE: SEPTEMBER 30, 1993

BY: TENNESON ENGINEERING CORP.
409 LINCOLN STREET,
THE DALLES, OREGON, 97058
PH. (503) 296-9177
FAX (503) 296-6657

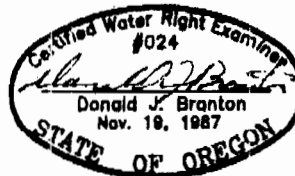

NOTE:

"THIS MAP IDENTIFIES THE LOCATION OF
THE WATER RIGHT ONLY AND IS NOT
INTENDED TO PROVIDE DIMENSIONS OR
LOCATE PROPERTY OWNERSHIP LINES."

W.O. #6780

RECEIVED

APR 7 6 2002

WATER RESOURCES DEPT.
SALEM, OREGON