

T.L. 401

T.L. 700

T.L. 404

T.L. 402 RECEIVED

SEP 27 1994

WATER RIGHTS DIVISION
SALEM, OREGON

CREEK

T.L. 701

T.L. 500

T.L. 502

T.L. 501

CREEK

EFU - 20

ROAD

T.L. 800

74.88 Ac. Ft.
AT MAXIMUM
WATER DEPTH

GARRET



PROPERTY



RESERVOIR

DRYLAND

750'

440'

22 23

27 26


SEC 23 T5S, R1E, W.M.



SCALE: 1" = 400'

1180PL01

CLAIM MAP
of
BENEFICIAL USE
R-11223

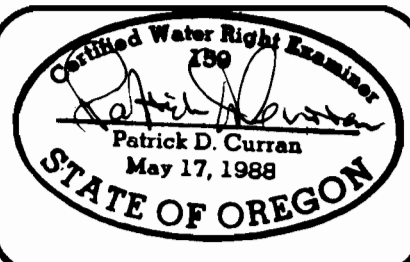

CURRAN-McLEOD, INC.
CONSULTING ENGINEERS
6655 S.W. HAMPTON ST., SUITE 210
PORTLAND, OREGON 97223
PHONE (503) 684-3478