


1" = 400'

Application R-69456  
Permit No. R11205

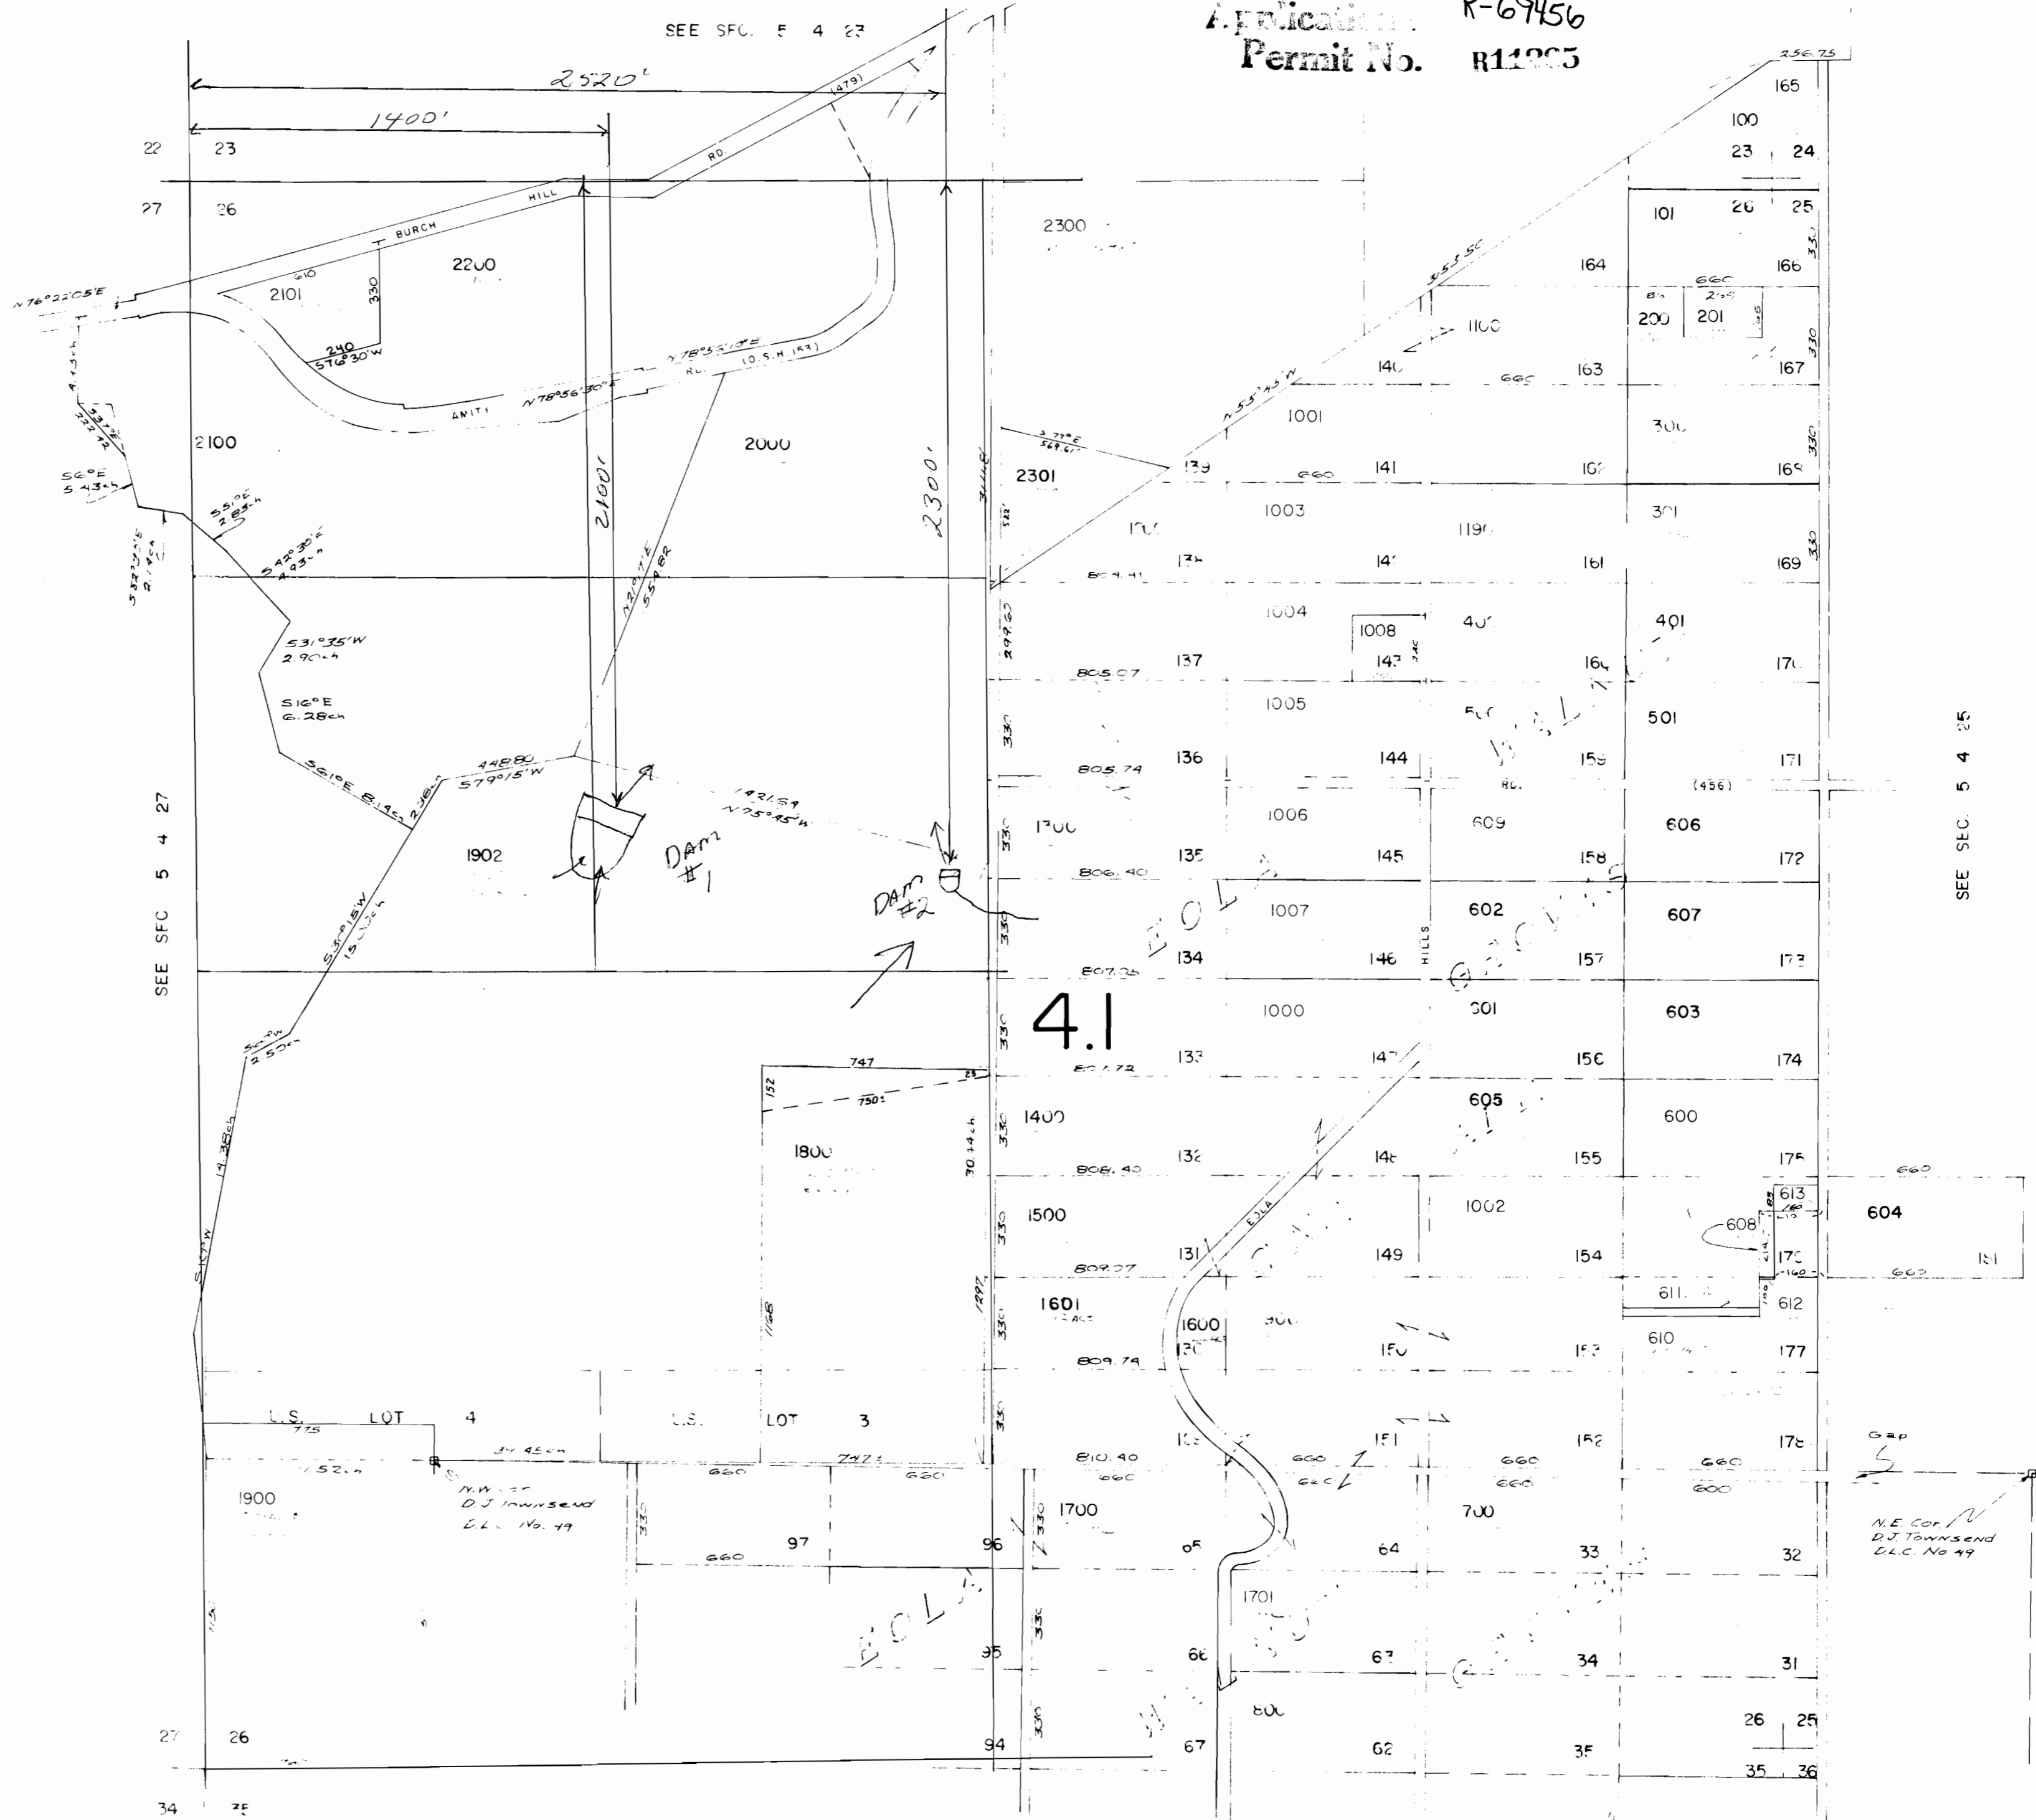

SEE SEC. 5 4 27

SEE SEC. 5 4 25

SEE SEC. 5 4 25