


PREPARATION OF THIS MAP IS FOR THE PURPOSE OF IDENTIFYING THE LOCATION OF THE NEIGHBORHOOD ONLY. THESE DIMENSIONS TO PROVIDE DIMENSIONS OF LOCATION OF PROPERTY OWNERSHIP LINES.

SCALE: 1" = 400'
 MAP BASE: 1936 ASSESSOR'S MAP
 1936 SEALED PHOTO


FINAL PROOF SURVEY
 SURVEYED SEPTEMBER 11, 1996

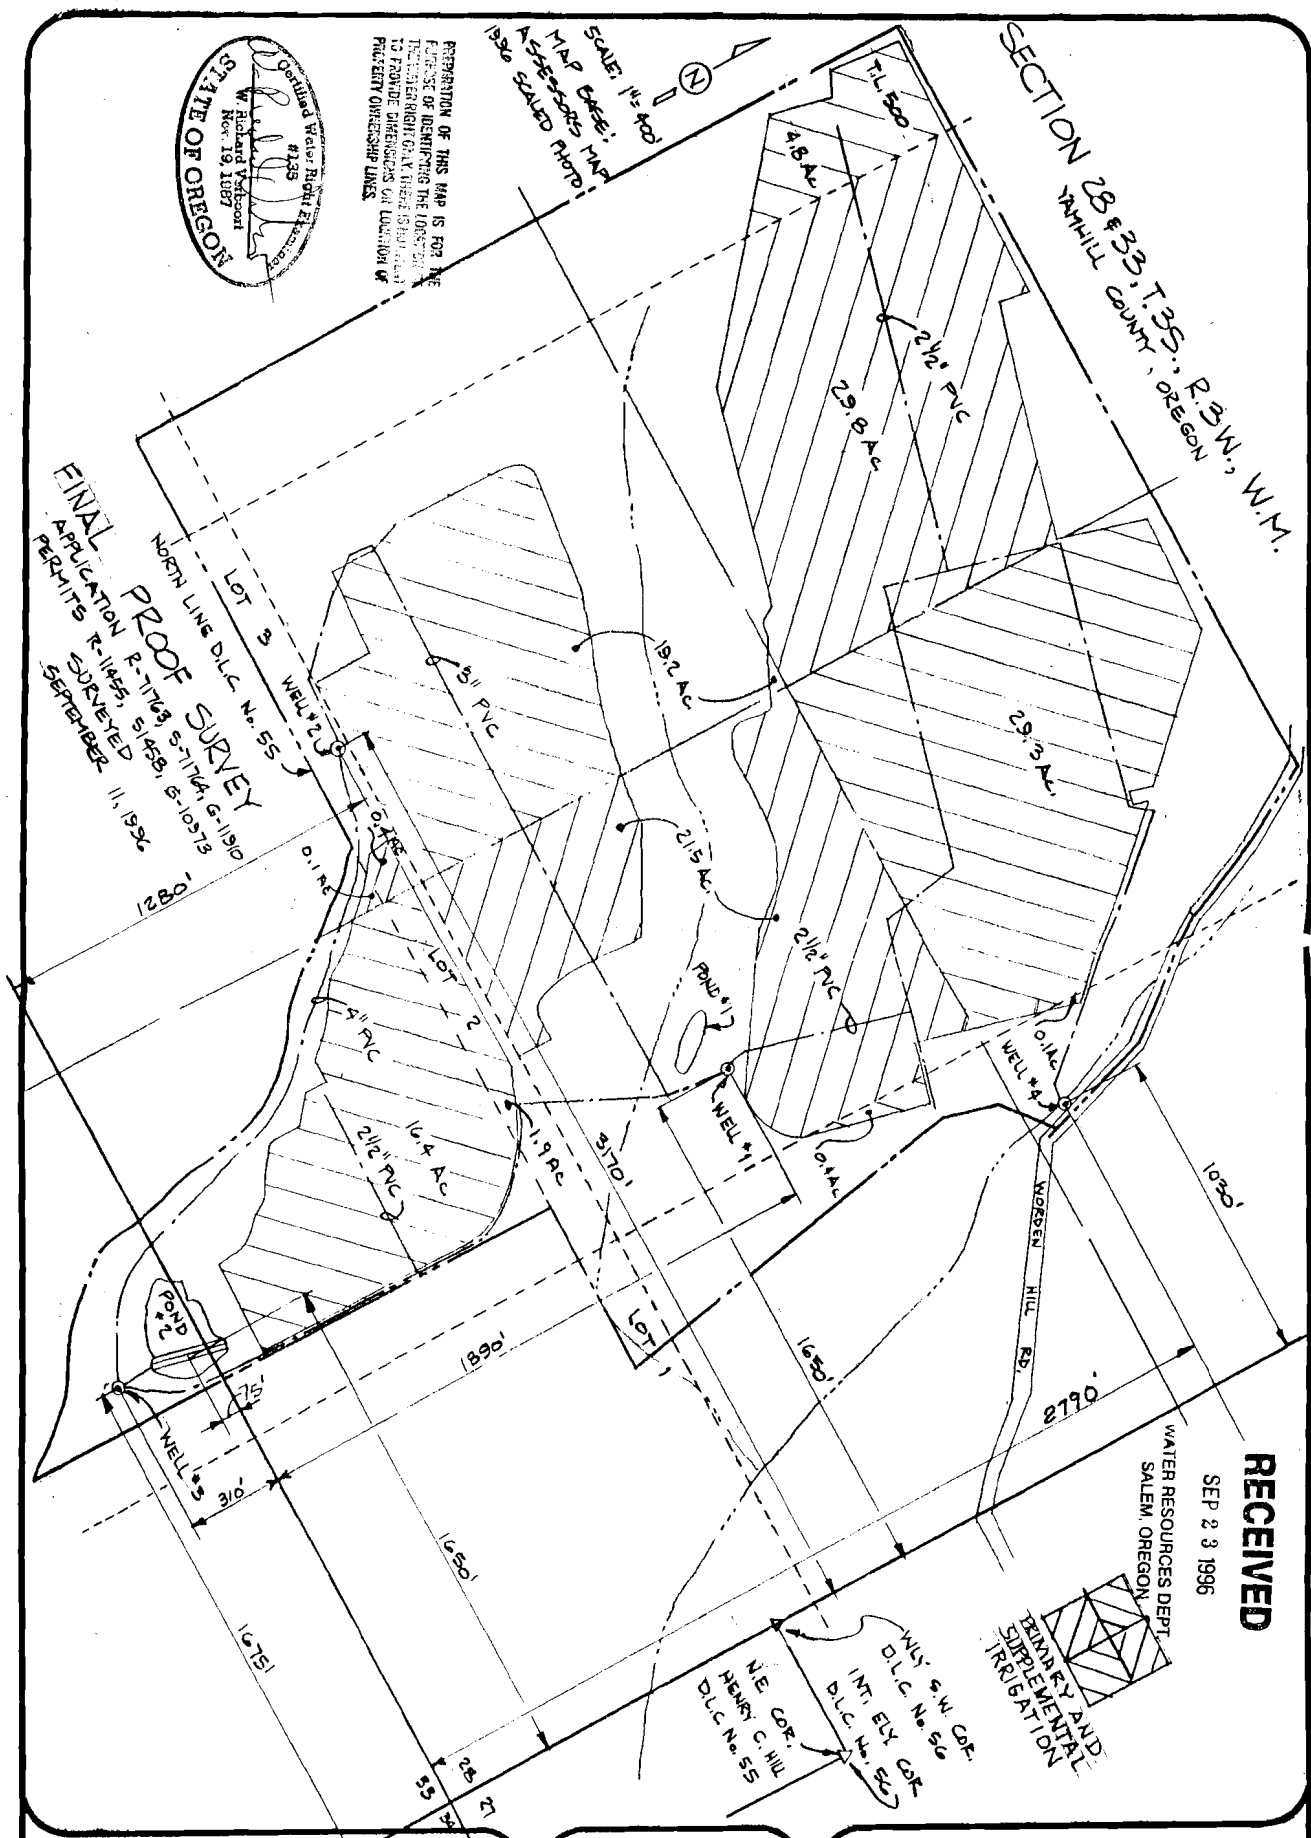

RECEIVED
 SEP 23 1996

WATER RESOURCES DEPT.
 SALEM, OREGON



N.E. COR.
 HENRY C. HILL
 D.L.C. No. 55

N.W. COR.
 D.L.C. No. 56

E.W. COR.
 D.L.C. No. 56

VERBOORT ENGINEERING
 AGRICULTURE • CIVIL • WATER RESOURCES
 HILLSBORO, OREGON

	by	date
designed	WRV	9.12.96
drawn	JER	9.12.96
checked	WRV	9.12.96
drawing no.	96-B-08	
sheet no.	1/1	

KNUDSEN VINE YARDS
 17000 NE KNUDSEN LANE
 DUNDEE, OR 97115