Application No. R-71956
Permit No.

T. 3 S., R. 1 W., W. M.

RECEIVED
OCT 21
OIL RESOURCES
SALEM, OREGON

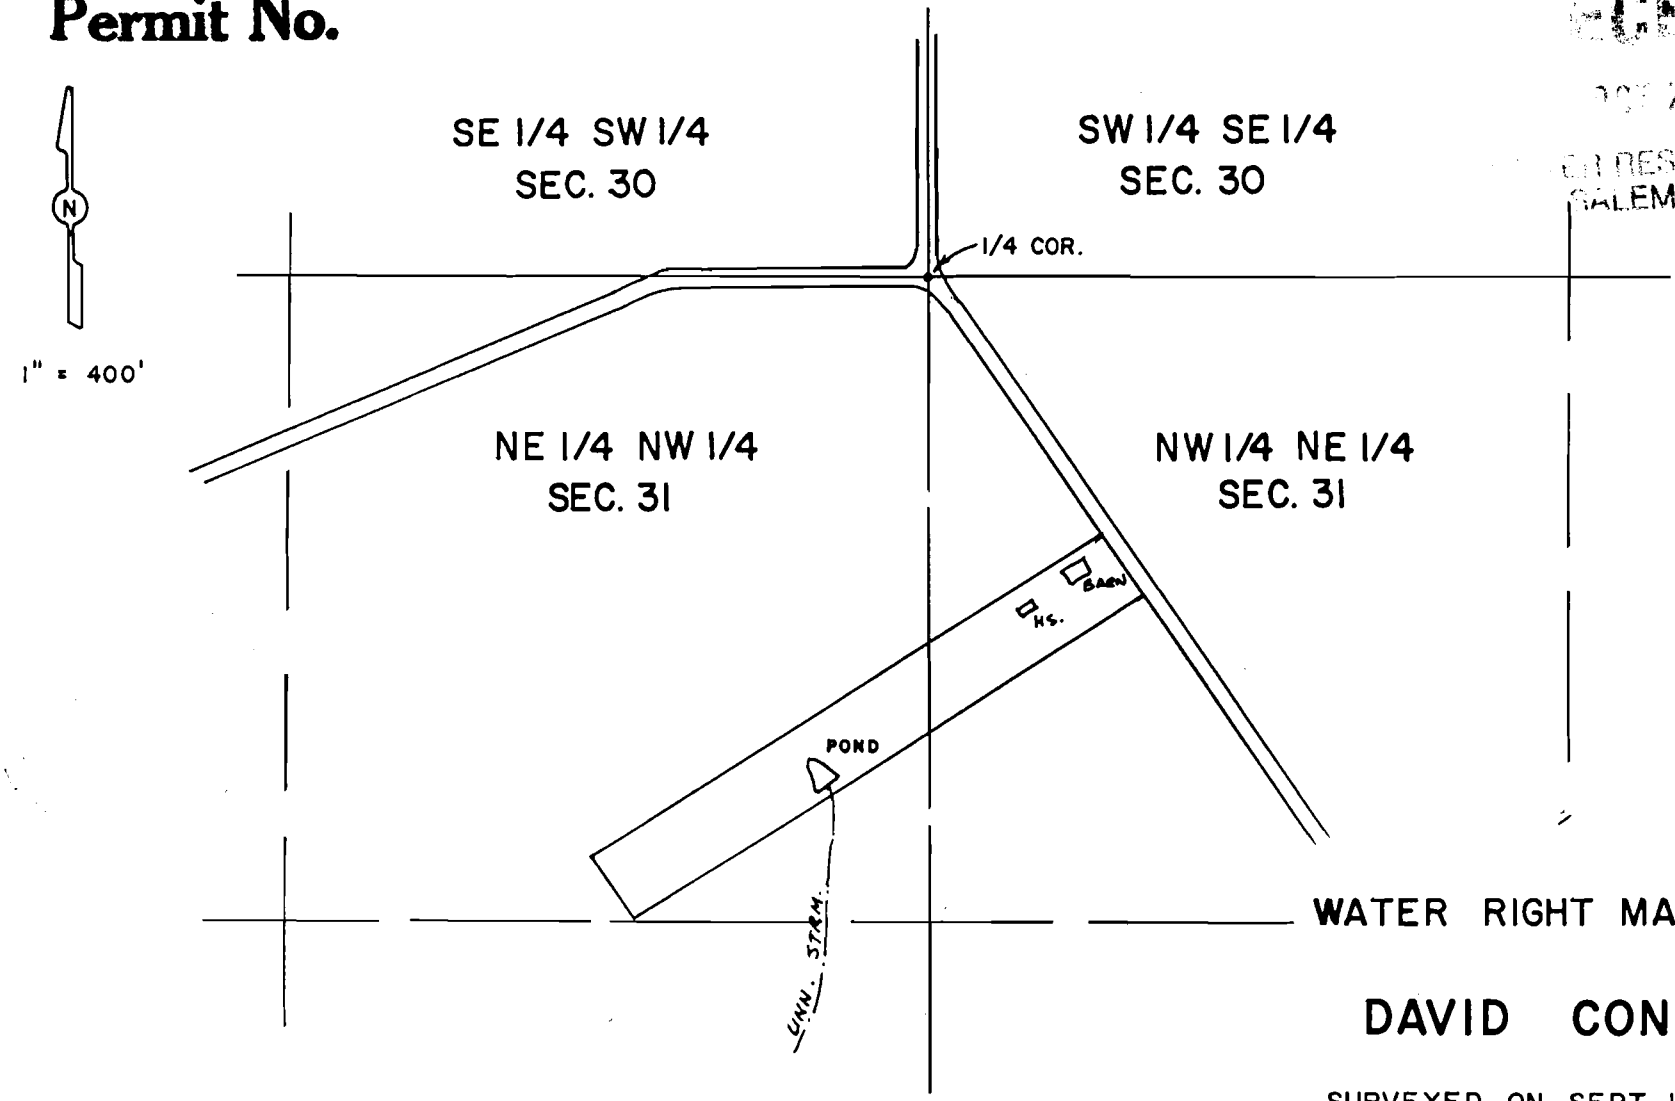

WATER RIGHT MAP FOR

DAVID CONNOR

SURVEYED ON SEPT. 11, 1991

BY: Larry V. Repousek
LARRY V. REPOUSEK
Dec. 7, 1989

Certified Water Right Examiner #229
STATE OF OREGON

THIS MAP WAS PREPARED FOR THE PURPOSE OF IDENTIFYING THE LOCATION OF A WATER RIGHT ONLY AND IS NOT INTENDED TO PROVIDE LEGAL DIMENSIONS OR LOCATION OF PROPERTY OWNERSHIP LINES.

POND LOC. 200' W. & 1050' S. FROM N.1/4 COR. SEC. 31