

RECEIVED

RECEIVED

RECEIVED

AUG 17 1992

AUG - 3 1992

19
30

20
29

AUG 1 1992

WATER RESOURCES DEPT.
SALEM, OREGON

WATER RESOURCES DEPT.
SALEM, OREGON

WATER RESOURCES DEPT.
SALEM, OREGON



4"=1 MILE

Application No. R-72632
Permit No. R11575

THIS MAP IS FOR THE PURPOSE OF IDENTIFYING
THE LOCATION OF THE WATER RIGHT ONLY AND
IS NOT INTENDED TO PROVIDE LEGAL DIMENSIONS
OR LOCATION OF PROPERTY OWNERSHIP LINES

DISTANCE TO RESERVOIR OUTLET CONTROL
STRUCTURE FROM NE CORNER OF SECTION
30, SOUTH 6547', EAST 1127'

AREA OF RESERVOIR LOCATED
IN DLC 38, 1.35 ACRES

LADD HILL RD

KRAMIEN RD

DLC 41

30 29
31 32

DLC 43

DLC 37

WILSONVILLE

DLC 38

WILLAMETTE RIVER


T.3S.

T.4S.

CLACKAMAS CO.

YAMHILL CO.

R.2W. R.1W.

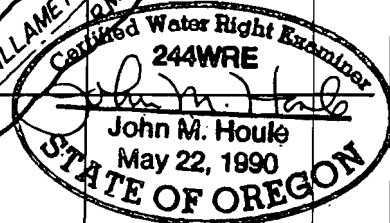

L4218, W00

APPLICATIONS TO CONSTRUCT A RESERVOIR &
APPROPRIATE SURFACE WATER

APPLICANT: BOB McCALL

otak
incorporated

engineers
planners
landscape architects
surveyors

17355 S.W. Boones Ferry Rd., Lake Oswego, OR 97035, (503) 635-3618
620 Kirkland Way, #500, Kirkland, WA 98033, (206) 822-4446

7/24/92