


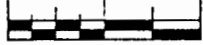

SCALE: 1" = 1320'
00 660 1320




GRAPHIC SCALE IN FEET

T.37S., R.5W., W.M. SECTIONS 19 & 30

JOSEPHINE COUNTY, OREGON

MAY 22 1994

WATER RIGHTS DEPT.
SALEM, OREGON

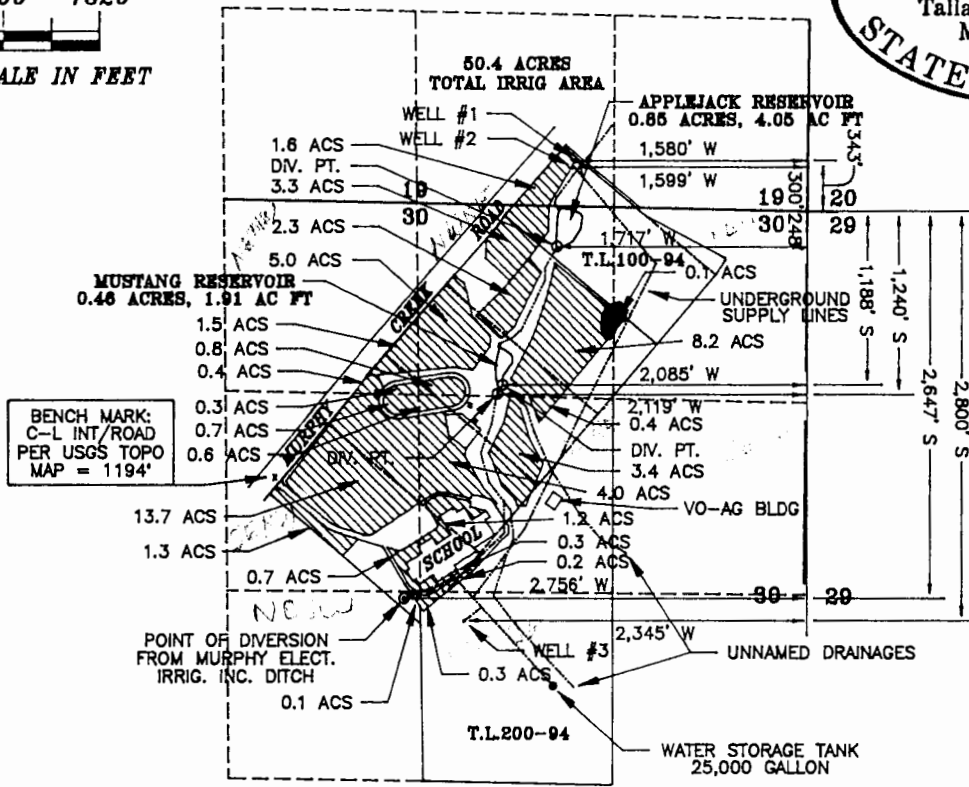

BENCH MARK:
C-L INT/ROAD
PER USGS TOPO
MAP = 1194'

BEARINGS & SURVEYED LOCATIONS
ARE BASED ON C.S.#134-88
& MURPHY CREEK ROAD SURVEY

APPLICATION MAP & FINAL PROOF SURVEY

FOR PERMIT TO APPROPRIATE SURFACE WATER (SUPPLEMENTAL IRRIGATION),
PERMITS TO APPROPRIATE SURFACE WATER (STORAGE, RECREATION),
FINAL PROOF SURVEY OF MUSTANG RESERVOIR AND FINAL PROOF SURVEY OF APPLEJACK RESERVOIR
IN NAME OF

JOSEPHINE COUNTY SCHOOL DISTRICT

Field Surveyed July 13 thru Aug. 3, 1993, by MAAKESTAD & ASSOCIATES, INC.



MAAKESTAD

* SURVEYING * MAPPING *
* WATER RIGHTS *

ASSOCIATES, INC.

303 N.E. "E" STREET, GRANTS PASS,
OREGON 97526 (503) 471-1113

JOB #: 93006
DATE: 03/08/94
DRAWN BY: TLH
FILE: 93006APM

PREPARED
FOR:

JOSEPHINE COUNTY SCHOOL DISTRICT
126 RINGUETTE STREET
GRANTS PASS, OR 97527 (503) 478-6304

SHEET
1 OF 3