
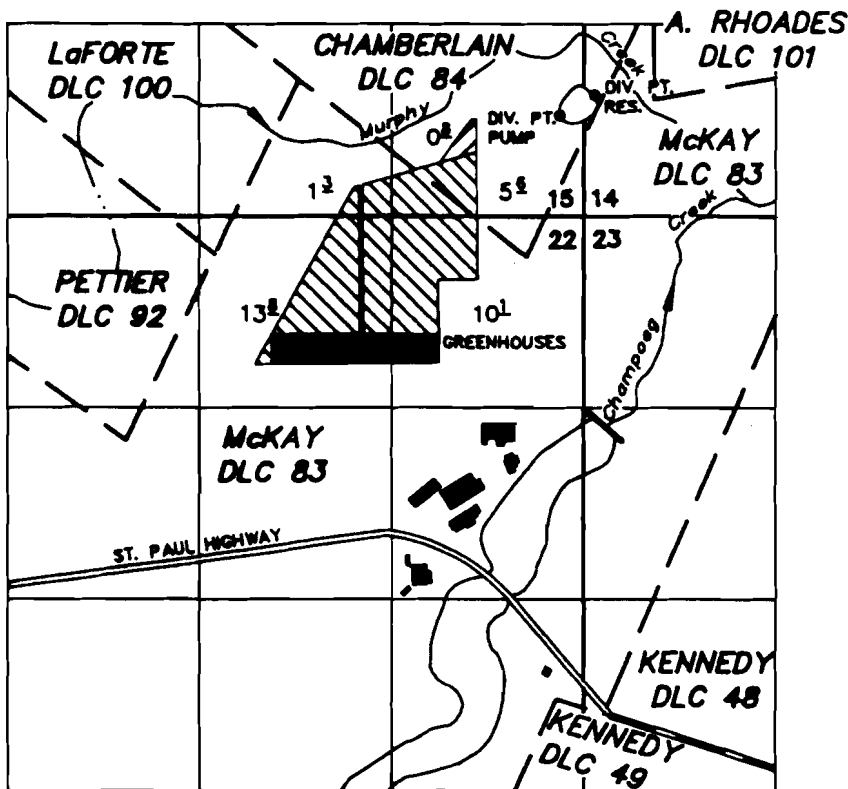


T.4S. R.2W. W.M.

MARION COUNTY

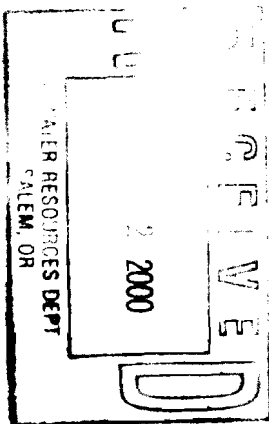

TAX LOTS:
 042W22 00100
 042W22 00201
 042W23 00400

RES. DIV. PT.: 34' N & 402' W FROM THE SW COR OF A. RHOADES DLC 101 IN SEC. 14
 PUMP DIV. PT.: 98' N & 657' W FROM THE SW COR OF A. RHOADES DLC 101 IN SEC. 15

FINAL PROOF SURVEY UNDER

- NURSERY OPERATIONS
- NURSERY OPERATIONS WITH IRRIGATION

GR-2514	R-44070	44071	R-71953	S-72042	Application No.
R-4964	32366	R-11676	51962	Permit No.	
GR-3833	39929	39930	Certificate No.		

A & R SPADA FARMS

SEPTEMBER 14, 1999
 SCALE: 1" = 1320'

NOTE: This map is for the purpose of identifying the location of water rights and has no intent to dimension or locate property ownership lines.

