


7-16

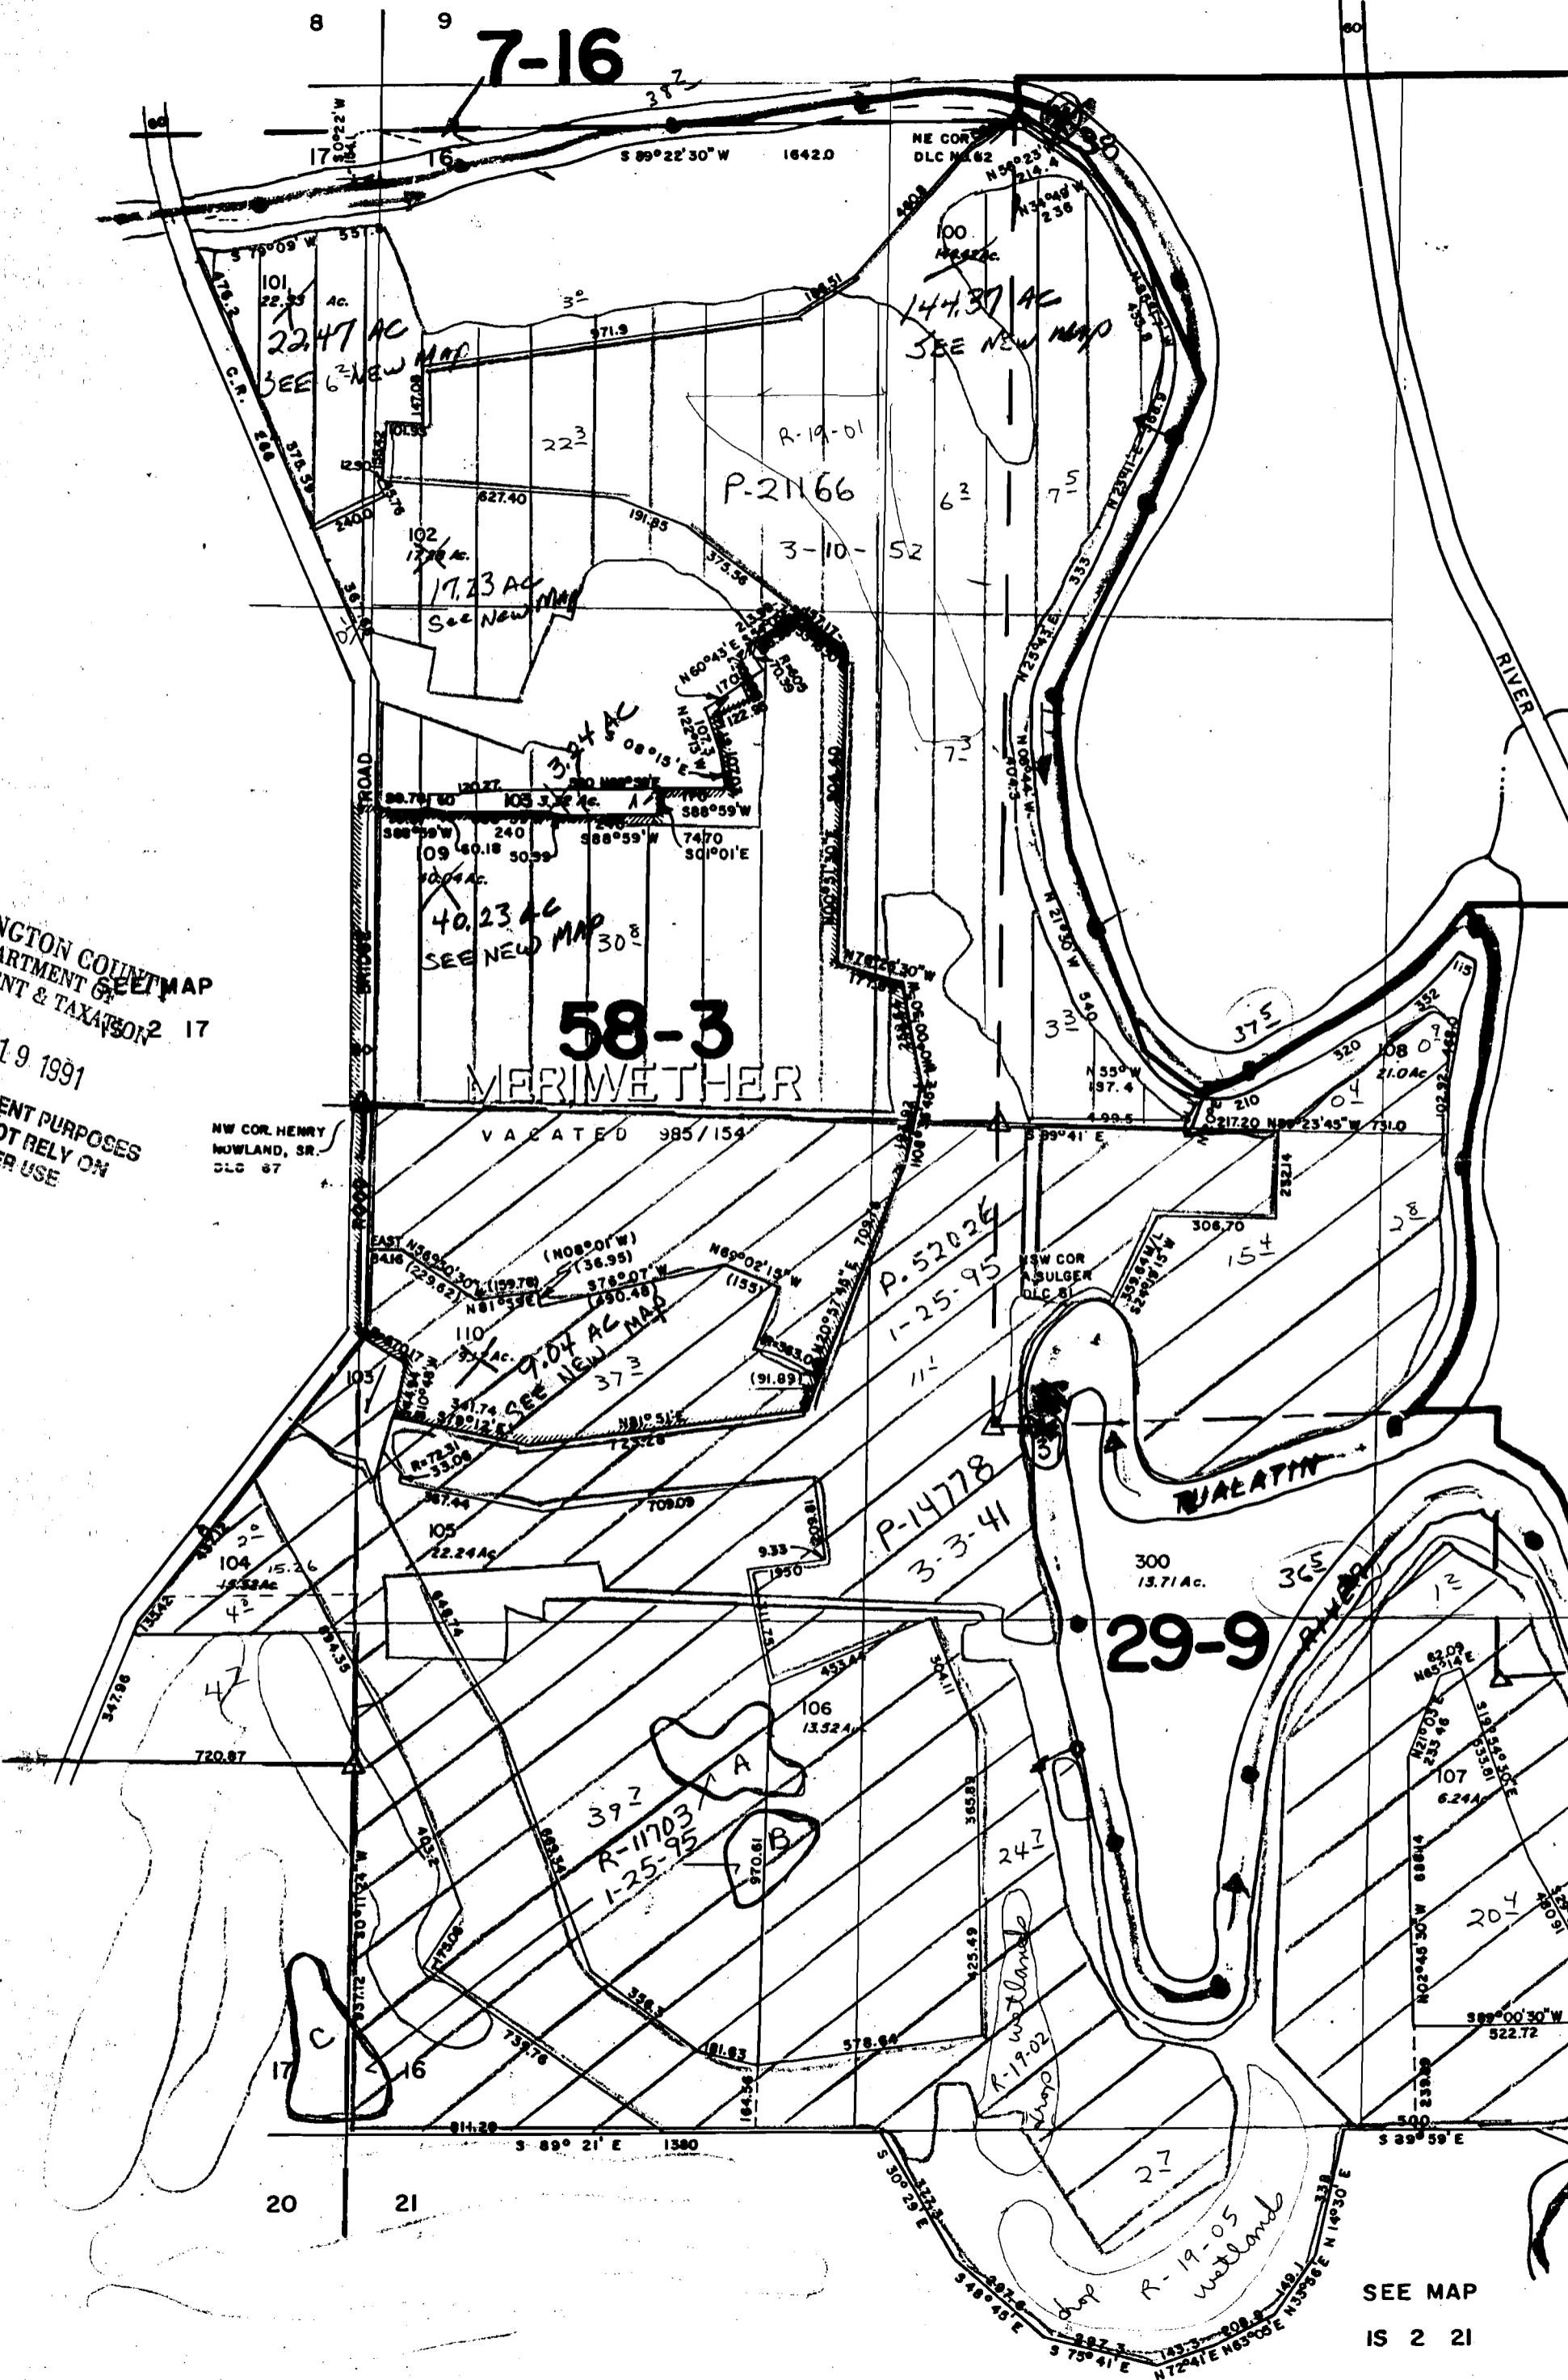

WASHINGTON COUNTY
DEPARTMENT OF
ASSESSMENT & TAXATION
NOV 19 1991
ASSESSMENT PURPOSES
ONLY - DO NOT RELY ON
FOR OTHER USE

58-3
MERIWETHER

29-9