


T 30 S. R 6 W. WM

SCALE 1" = 1320'

RECEIVED
SEP - 5 1990
WATER RESOURCES DEPT.
SALEM, OREGON

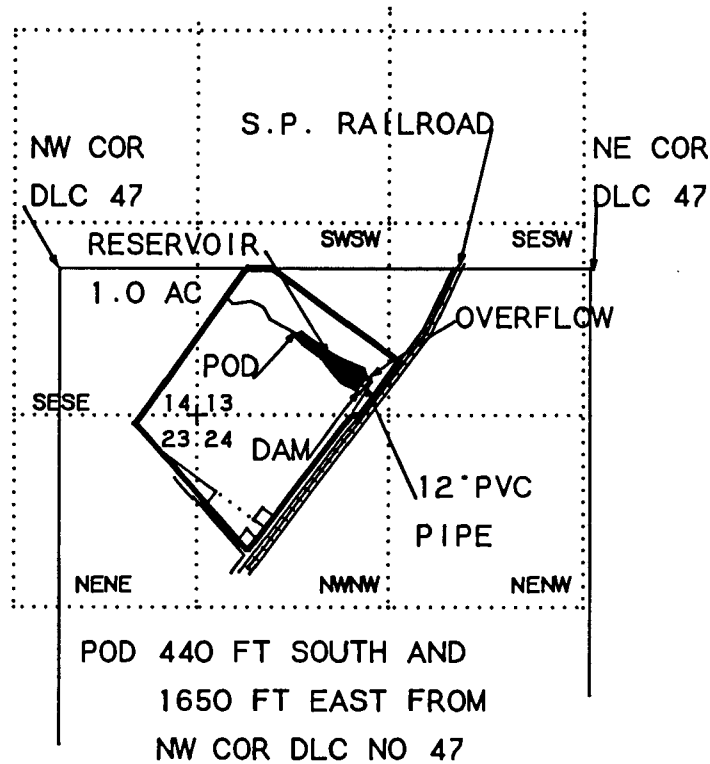

FINAL PROOF SURVEY
UNDER

Application No. ^{R. 70624} 70625 Permit No. R11767

IN NAME OF

GLENBROOK NICKEL COMPANY

Surveyed July 27, 1990 BY M E Farr

Certified Water Right Examiner
#046 WRE
Maurice E. Farr
Maurice E. Farr
Nov. 19, 1987
STATE OF OREGON
8-90