


FINAL PROOF MAP

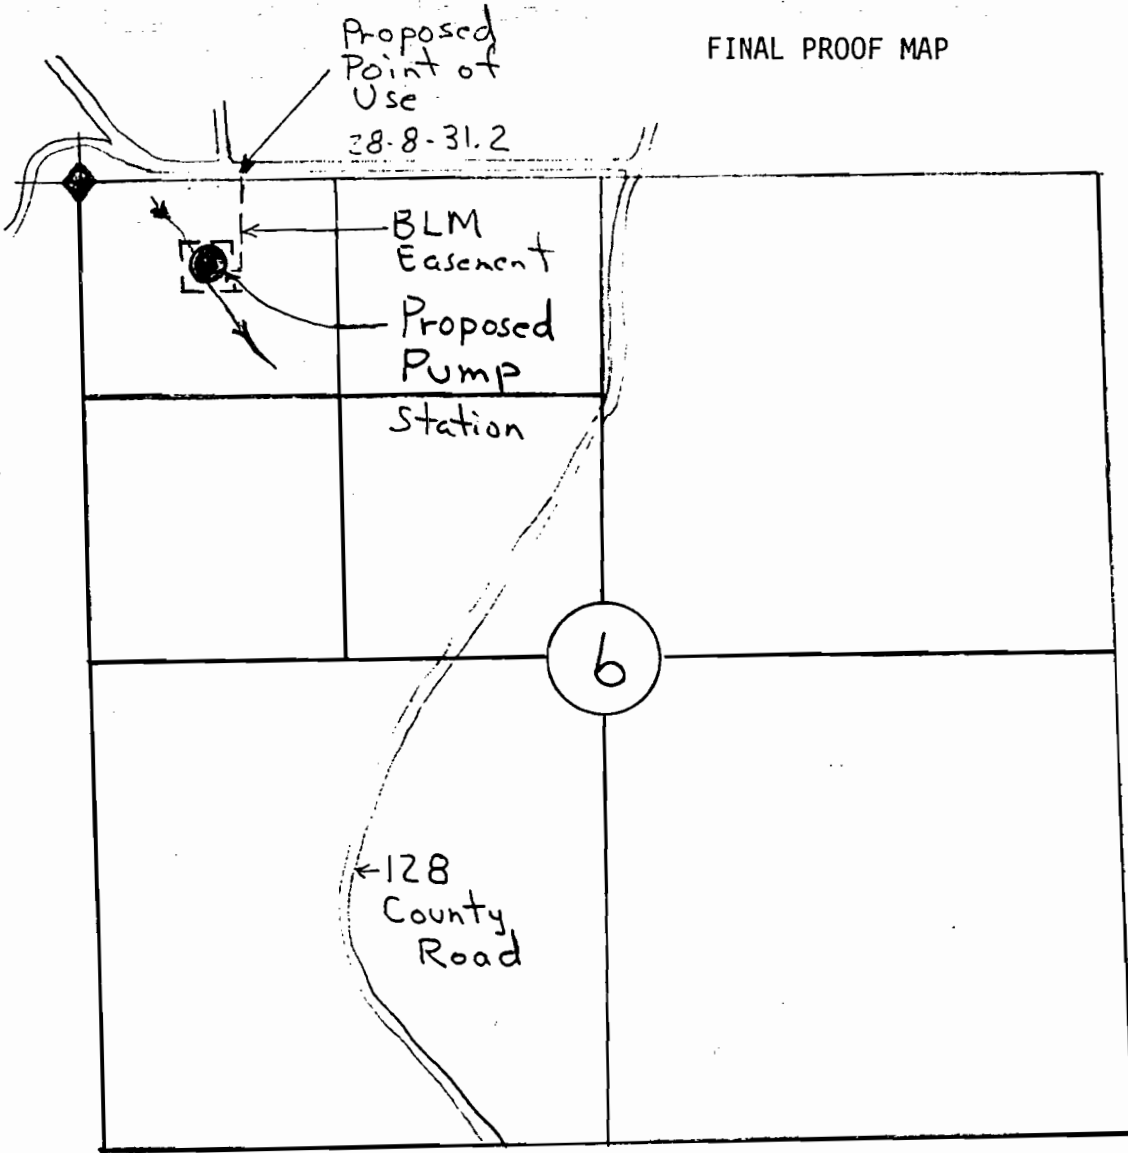

BLOOD DROP PUMP CHANCE
 T29S R8W Sec 6
 NW $\frac{1}{4}$ NW $\frac{1}{4}$


This pond is located on private land BLM has a 10 ft wide easement as shown,

The proposed pump station is located 460 ft South and 705 ft East from the Northwest Section corner of Section 6. The proposed point of use is located 10 ft North and 835 ft East from the Northwest Section corner of Section 6.

The map is shown for the purpose of water application and not property boundary.

Coordinate Ties are based on aerial photo 2-5-23-89.

APPLICATION: 70520, R. 70705
 PERMIT:

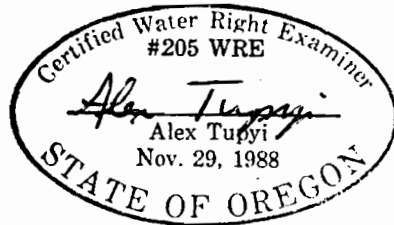

3-5-90