


PERMIT R-11976
Vol. 6.
APPLEGATE RIVER
4-18-96

409
500
600

SEE 1

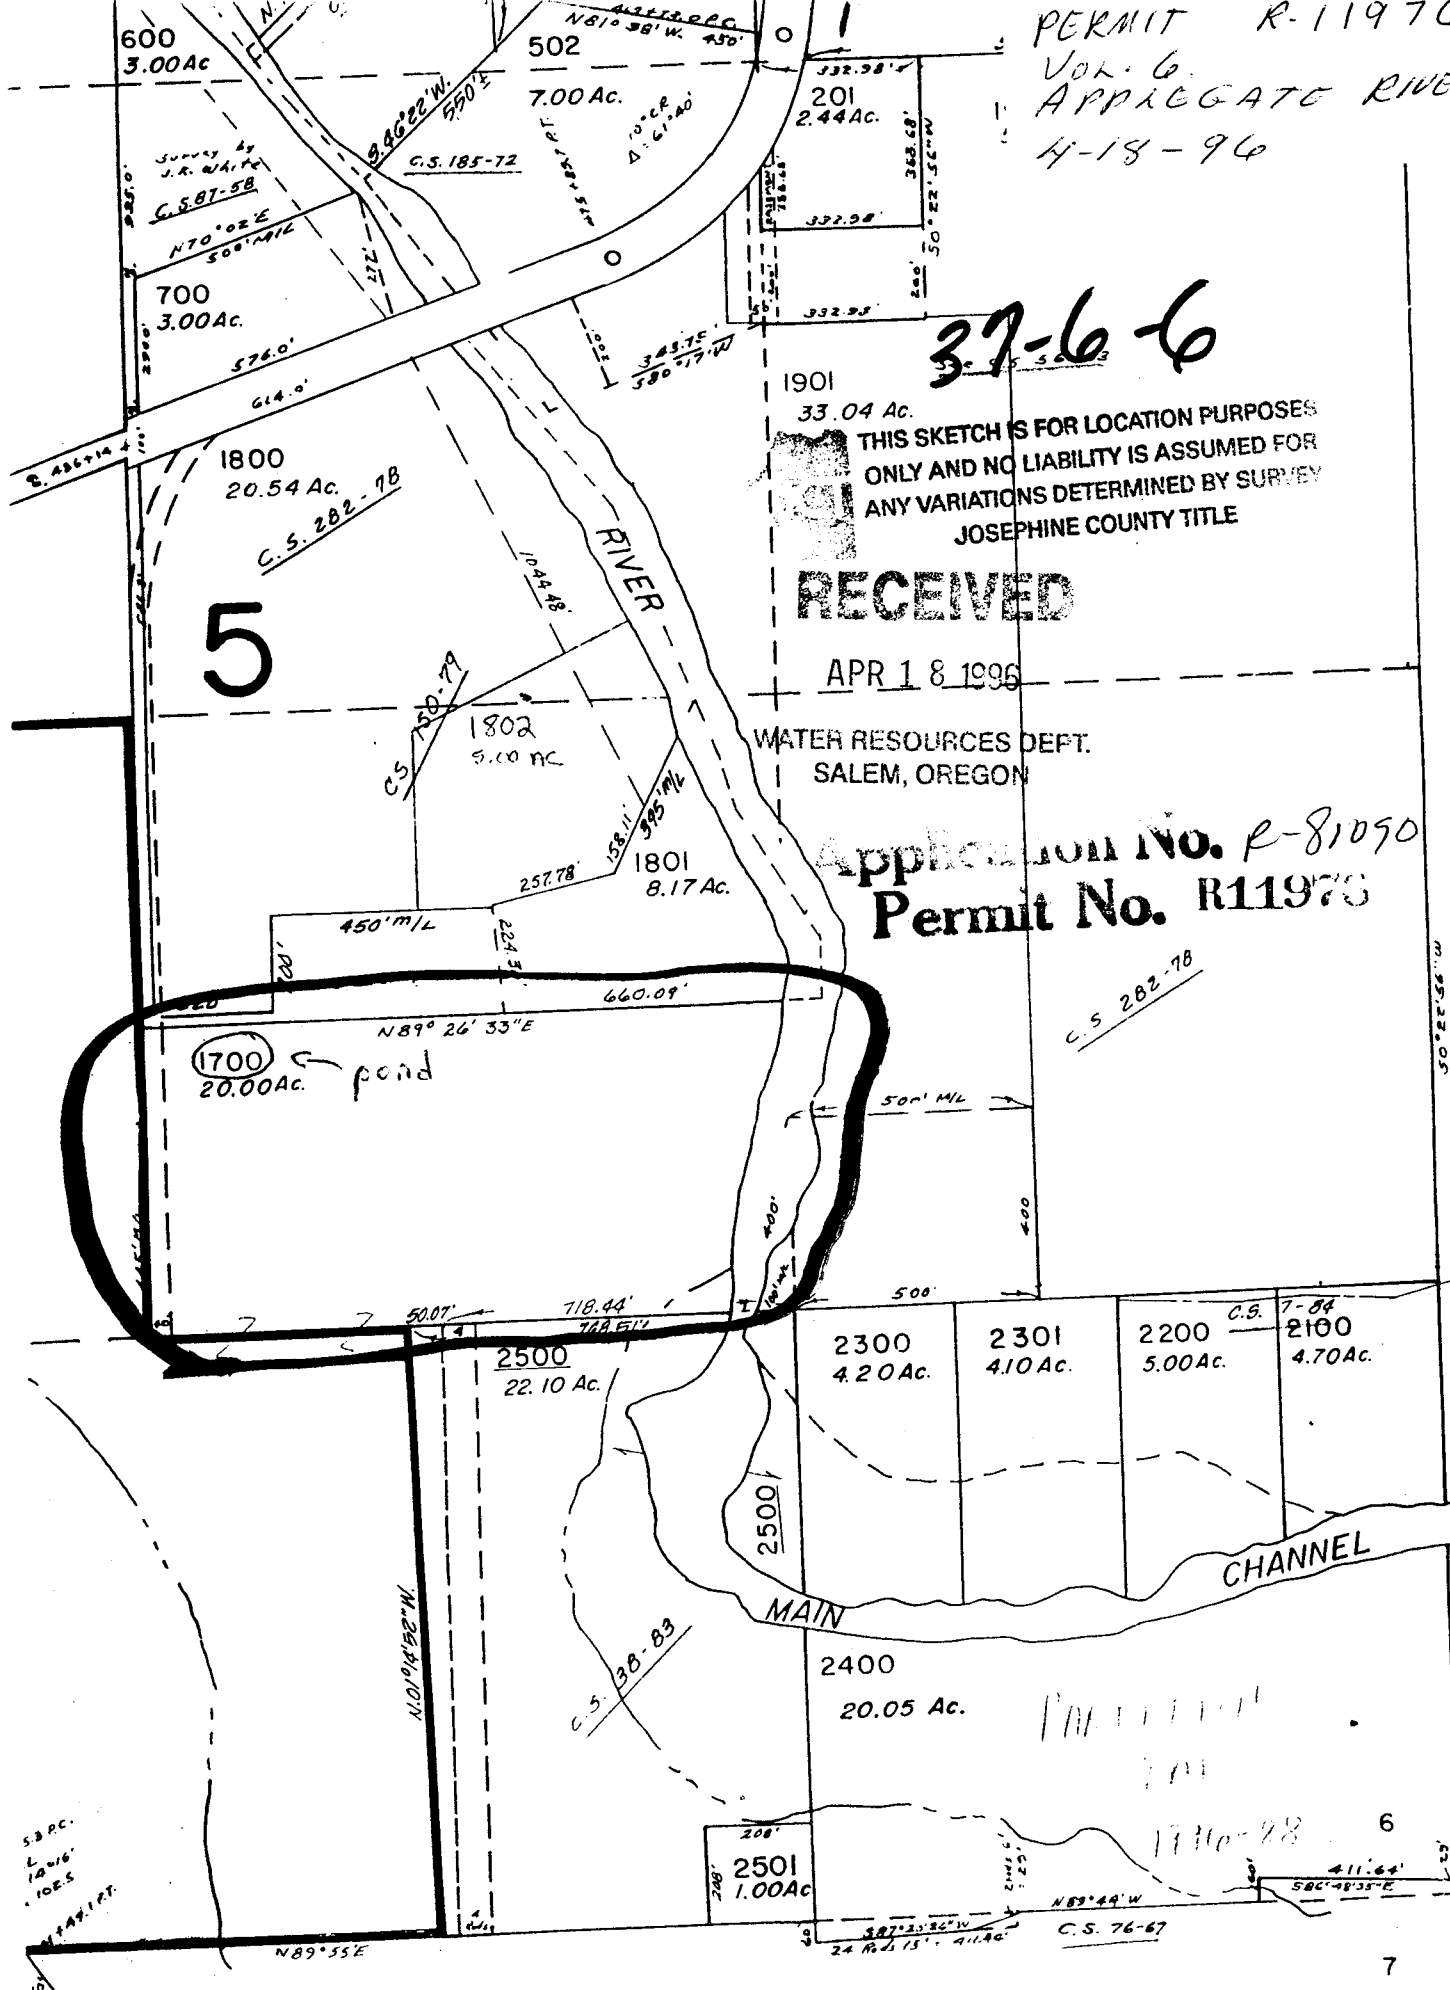

37-6-6

THIS SKETCH IS FOR LOCATION PURPOSES
ONLY AND NO LIABILITY IS ASSUMED FOR
ANY VARIATIONS DETERMINED BY SURVEY
JOSEPHINE COUNTY TITLE

RECEIVED

APR 18 1996

WATER RESOURCES DEPT.
SALEM, OREGON

Application No. R-81090
Permit No. R11976

5

52476

SEE MAP 37 6 5

5
6
7
8

S.B.P.C.
L. TAUG.
10E.S.

PHOTO

1710-28

6

7

5

8