

**RECEIVED**


~~PROOF~~ MAP

AUG 27 1995

AUG 10 1995

WATER RESOURCES DEPT.  
SALEM, OREGON

WATER RESOURCES DEPT.  
SALEM, OREGON

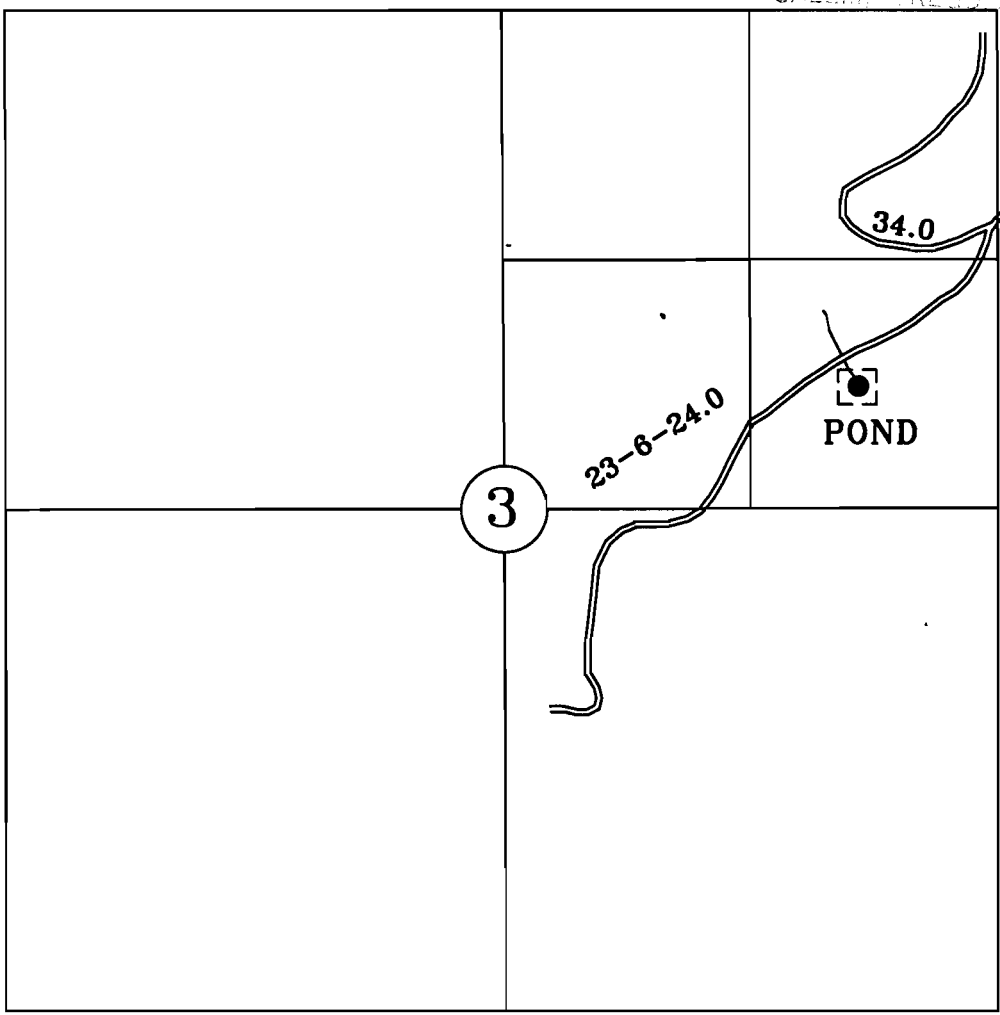

SCALE

1" = 1000'

YELLOW CREEK MTN. POND  
 T24S R6W SEC 3 W. M.  
 SE1/4 NE1/4

The point of diversion is located approximately 700 ft North and 750 ft West from the East Quarter Corner of Section 3.

Coordinate ties are based on aerial photo.

The Map is shown for the purpose of water application and not property boundary.

Application No. R-80594  
 Permit No. R12088

