


T.30S. R.15W.W.M.
SEC. 11

MAR 17 1993

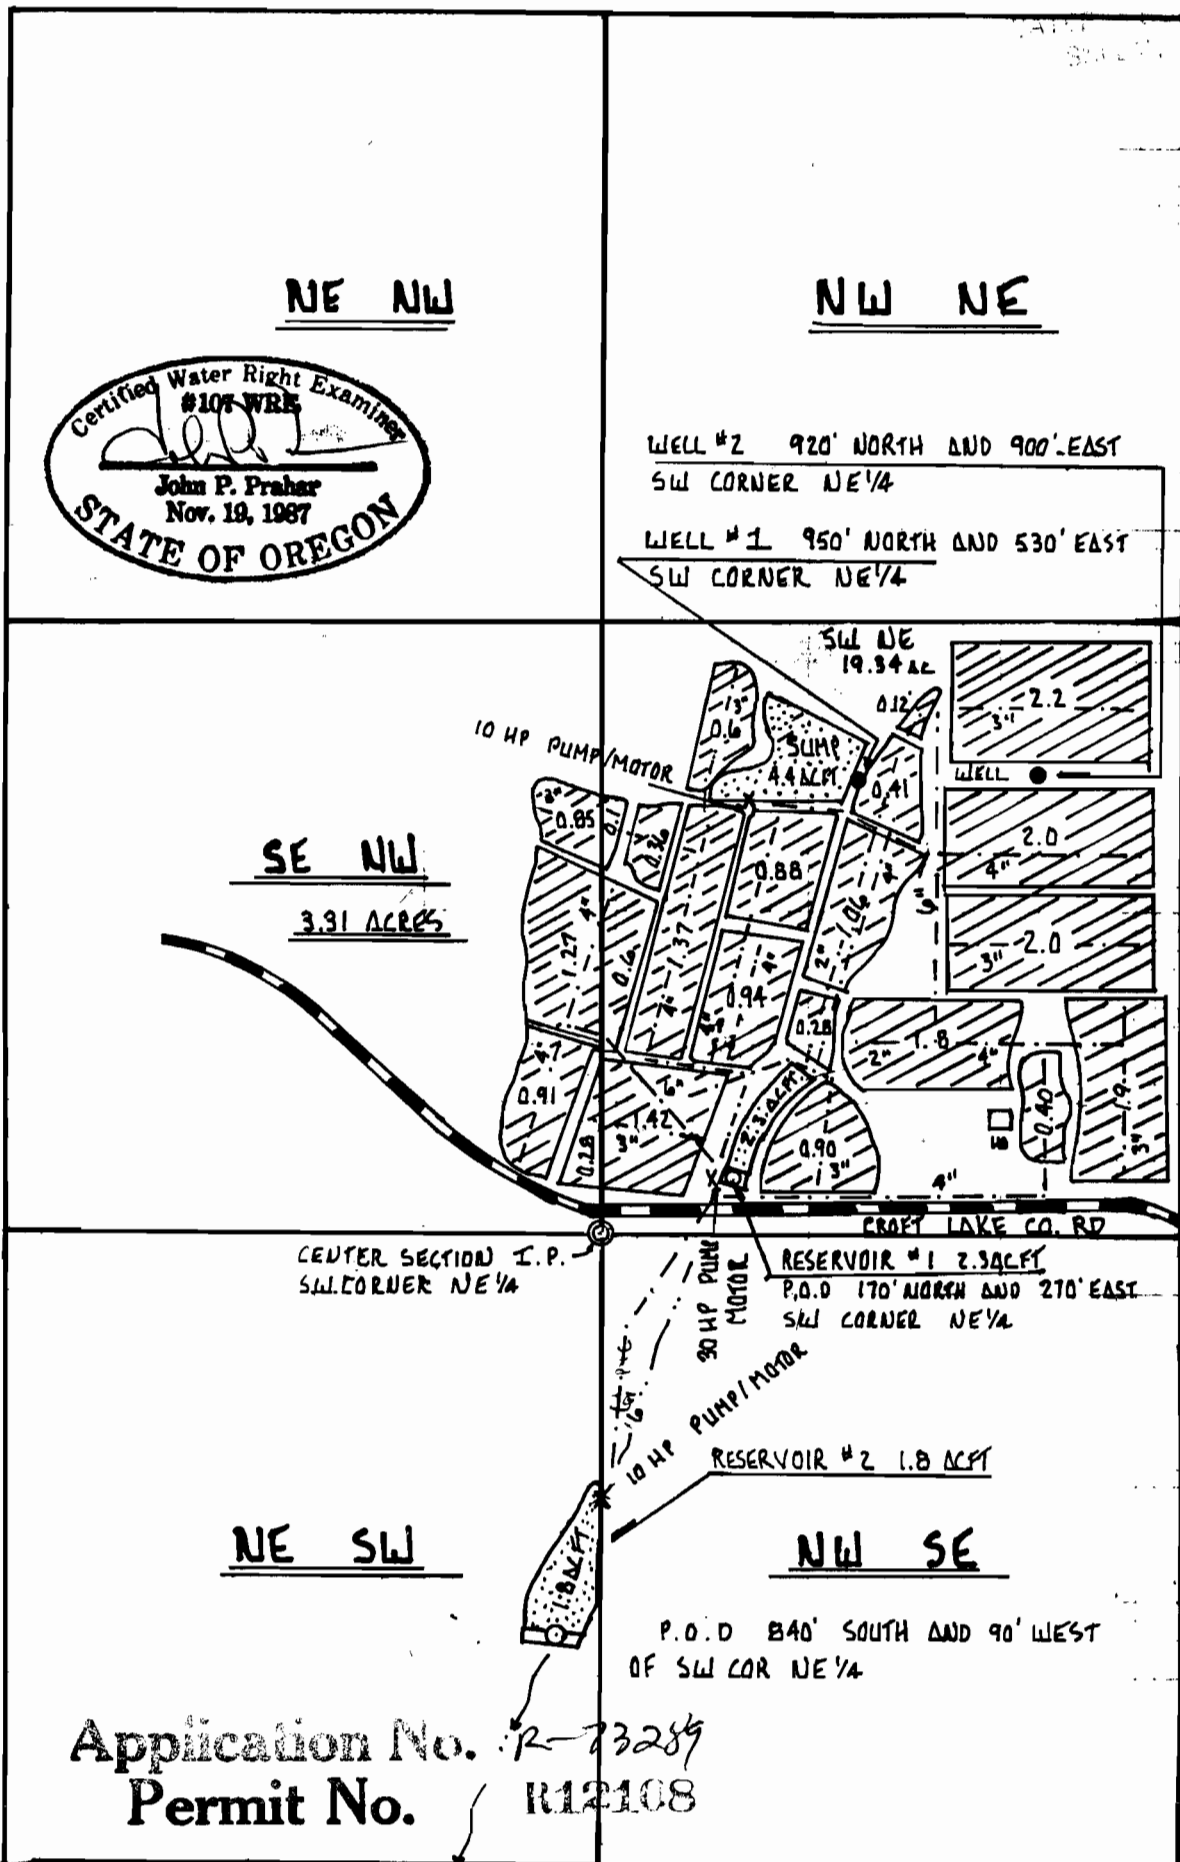

MAP TO ACCOMPANY THE APPLICATIONS TO APPROPRIATE, CONSTRUCT 2 RESERVOIRS AND APPROPRIATE GROUND WATERS IN COOS COUNTY, STATE OF OREGON

PREPARED FOR: Kenneth Hunnicutt
Rt. 1 Box 1485
Bandon, OR 97411
(503)347-2785

PREPARED BY: Prahar Surveying
1045 Baltimore #1
Bandon, OR 97411
(503)347-9517

DATE: Feb. 24, 1993

Disclaimer: This map was prepared for the sole purpose of locating a water right and is not intended to give legal dimensions or show property ownership lines.

LEGEND

- ⊙ monuments found
- stream
- Croft Lake Rd
- points of diversions
- main waterlines
- ▨ reservoirs/sumps
- x pump/motors
- wells