ASSESSMENT & TAX FILMED 12/8/95

SECTION 31 T1S R1W W.M.

WASHINGTON COUNTY OREGON

SCALE 1"=400'

IS 1 31

CANCELLED TAX LOTS

300, 2000, 1000, 1500, 1501, 1502, 1503, 1504, 1505, 1506, 200, 201, 202, 203, 204, 205, 206, 400, 401, 402, 403, 404, 405, 406, 407, 1100, 1101, 1102, 1103, 1200, 1201, 1202, 1300, 1400, 1401, 100, 101, 1601, 1606,

Application No. R-81474
Permit No. R12137

Location of well: Plan scale: 1" = 400' Less than 1/4 mile corner of map.

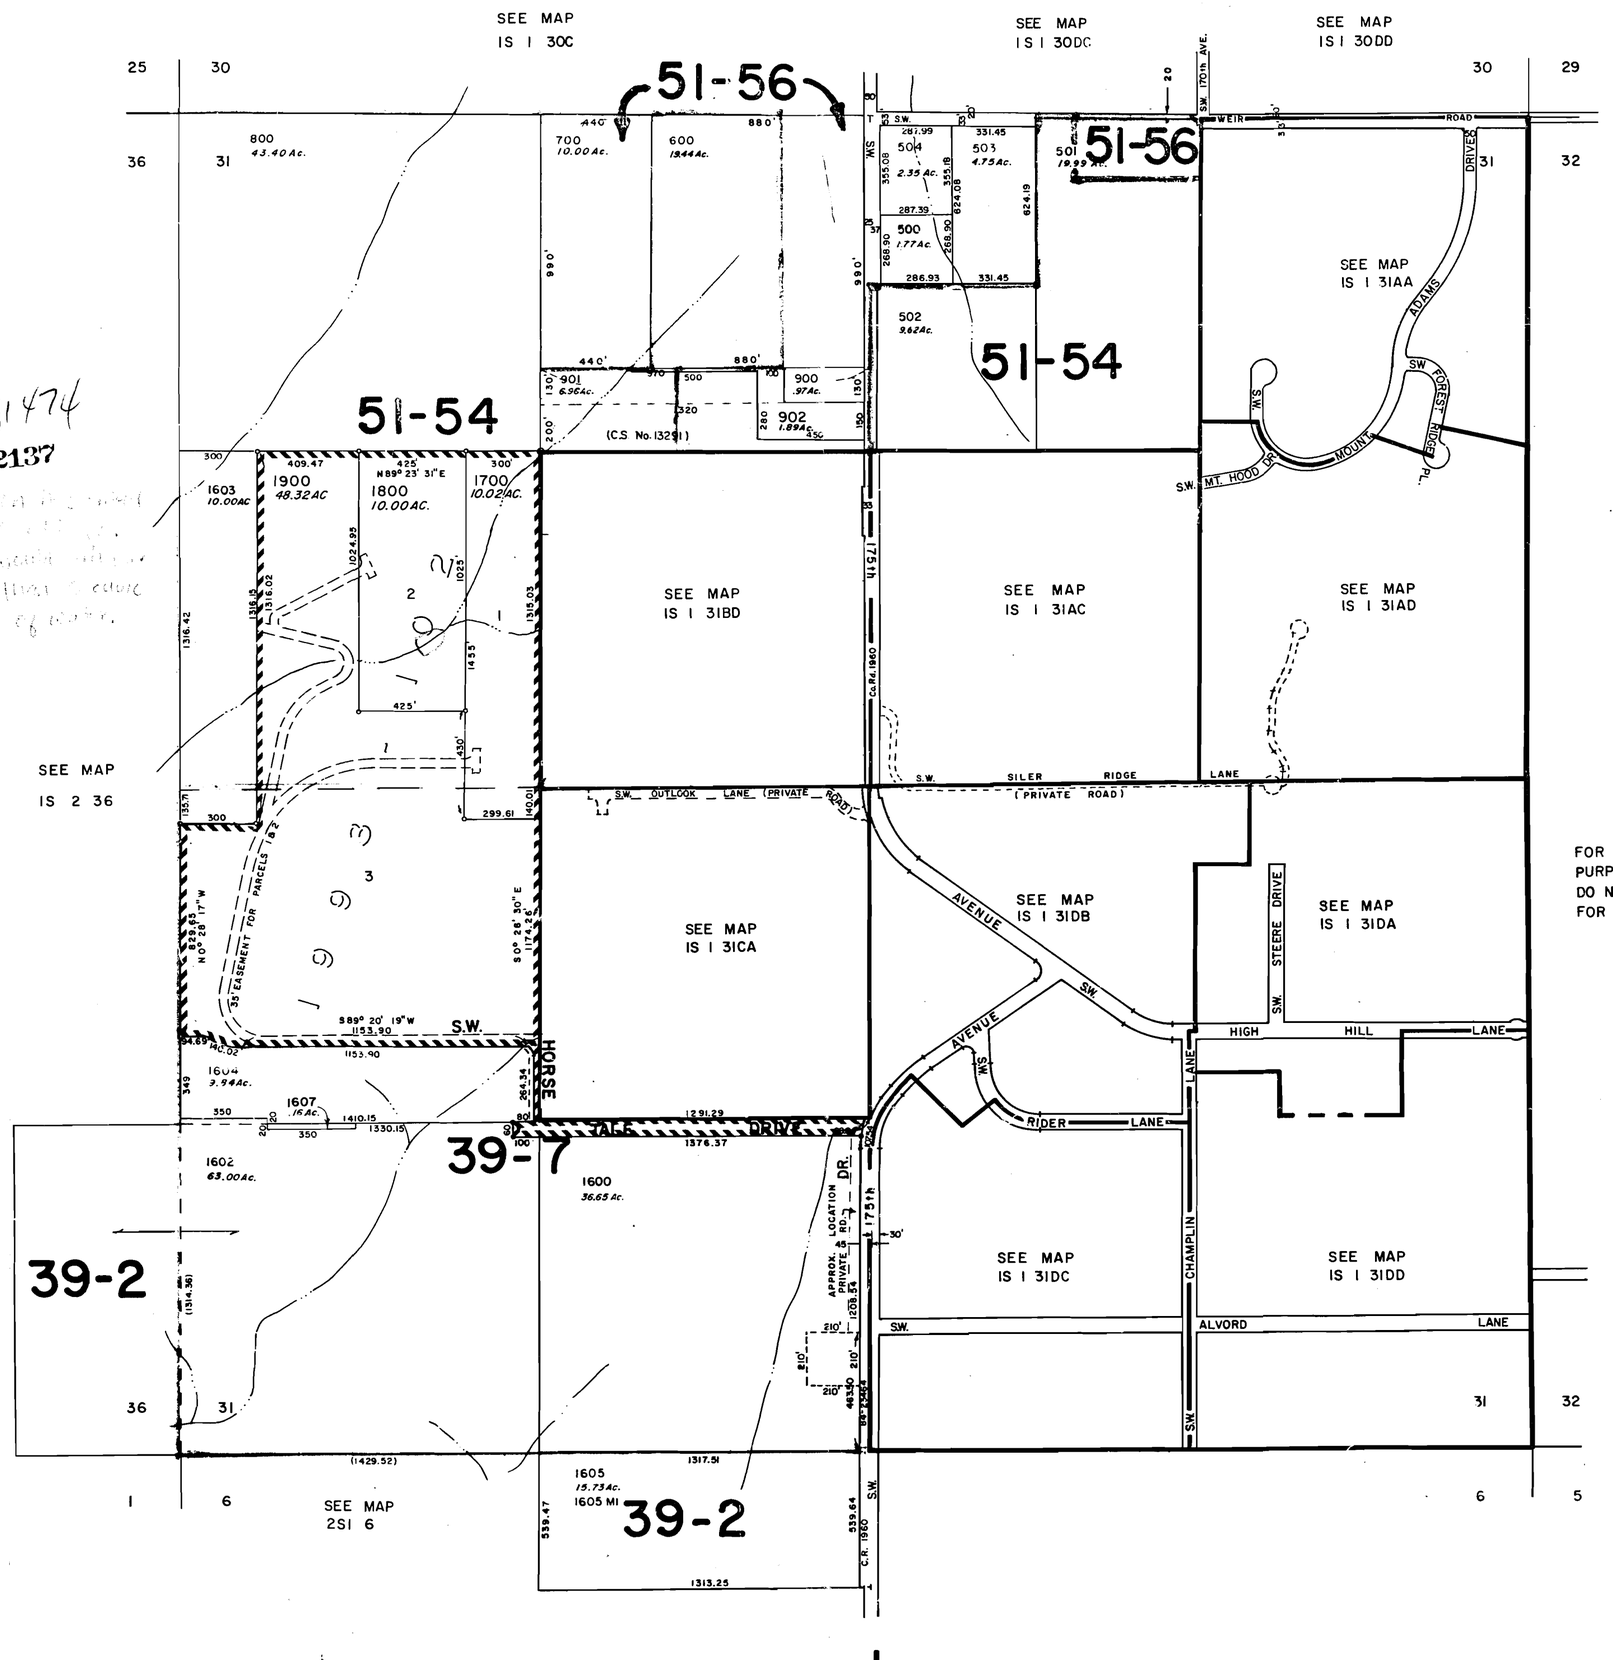

FOR ASSESSMENT PURPOSES ONLY
DO NOT RELY ON FOR ANY OTHER USE

NOT TO SCALE

WASHINGTON COUNTY SURVEYOR
FILED
AUG 27
HILLSBORO, OREGON

O.W. 8/13/53

IS 1 31