


SE1/4 SEC 27 T.8S. R.3W. WM
MARION COUNTY, OREGON

8 3W 27D


SEE MAP 8 3W 27A

DELETED TAX LOT
NUMBERS
01900
02500
01400
00101

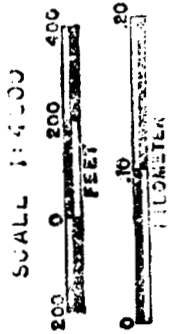

POND
40 FEET LONG
BY 30 FEET
WIDE

POND LOCATED
60 FEET EAST
OF HICKART LA.
AND 40 FEET
NORTH OF THE
SOUTH BOUNDARY

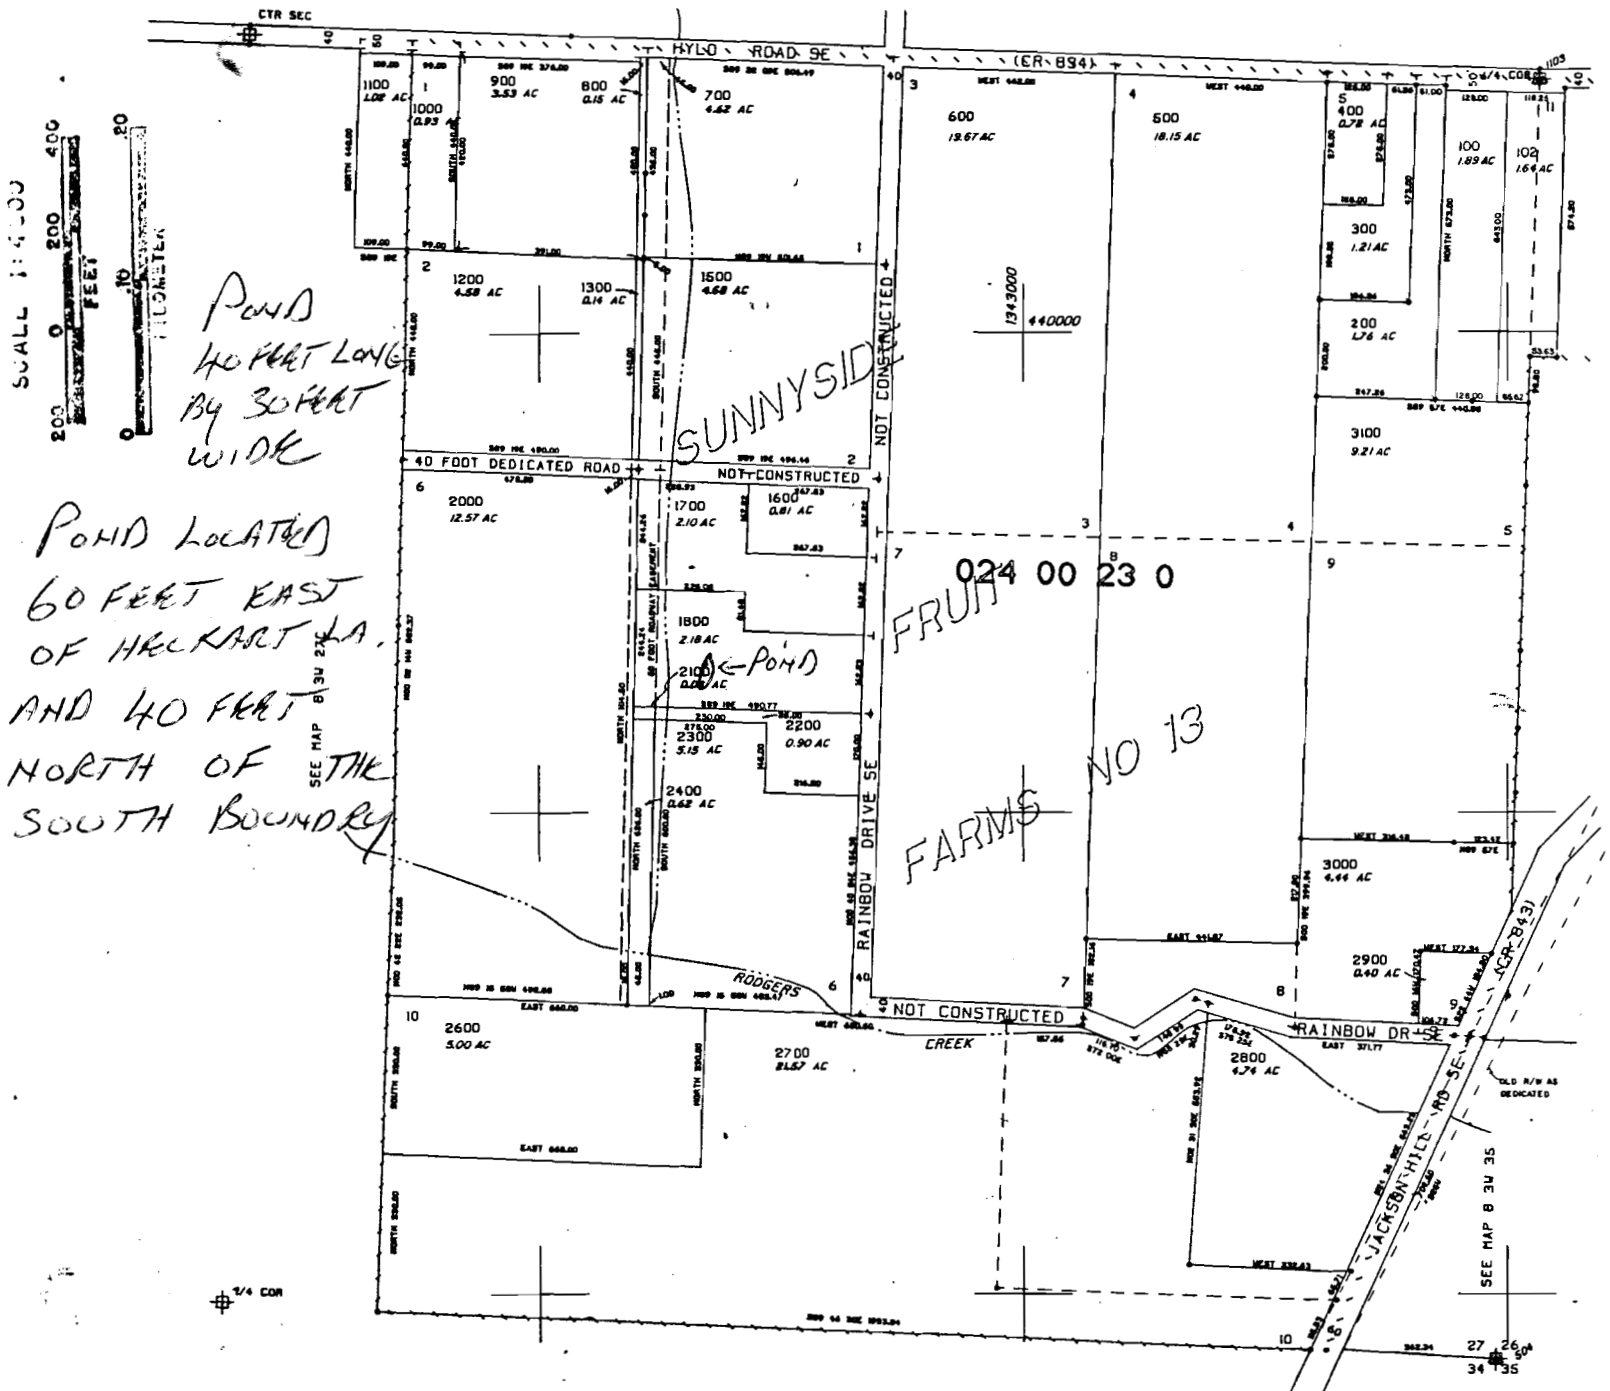

1"=200'
28-OCT-81

R2161

2-81586

SEE MAP 8 3W 26C

DATE 6-9-1998

SEE MAP 8 3W 35