


N
ASSUMED

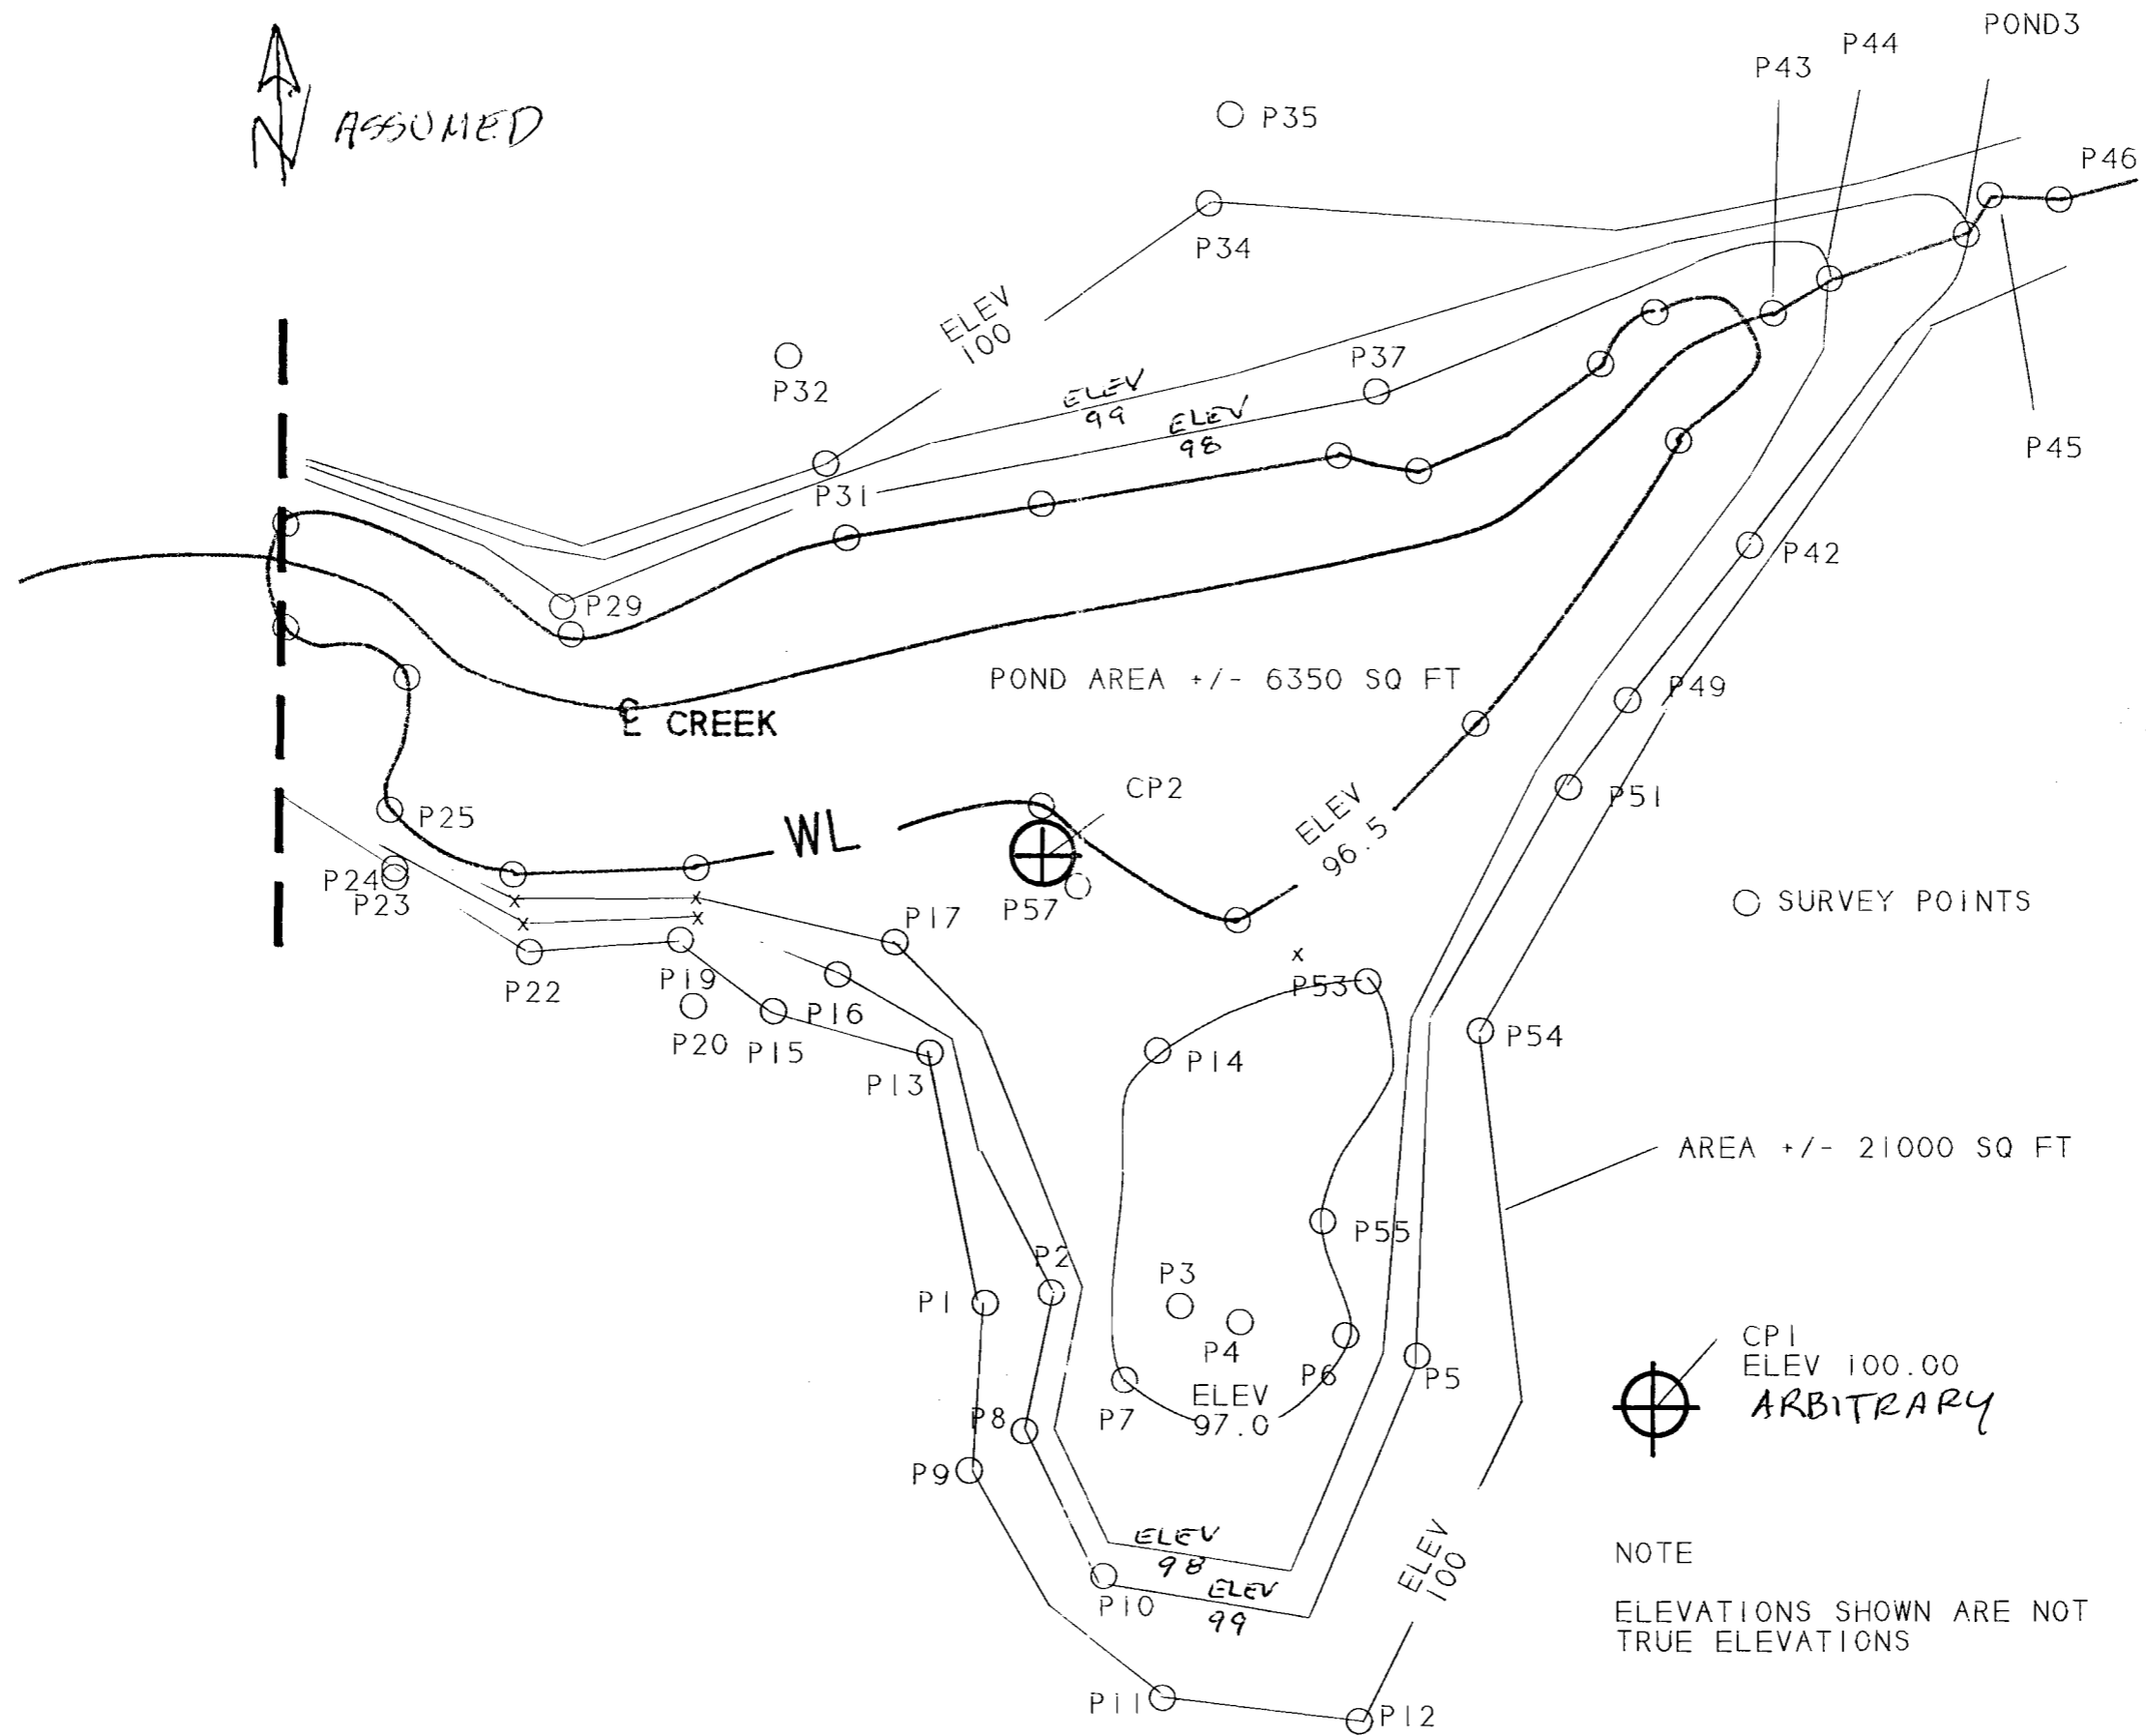

CITY OF HAPPY VALLEY
PARKS DEPARTMENT

WILDLIFE PARK POND

Dwg VOS

8/4/96

Dwg 9012-93Y1

Rev 0

81476
R12176
Permit No.