


Permit: R 12199
Vol: 1A
Strm:
Trib: Schoolhouse Cr
Priority: 8/5/1996

T. 35S., R. 6W., W. M.

Sec. II

SE 1/4 SW 1/4

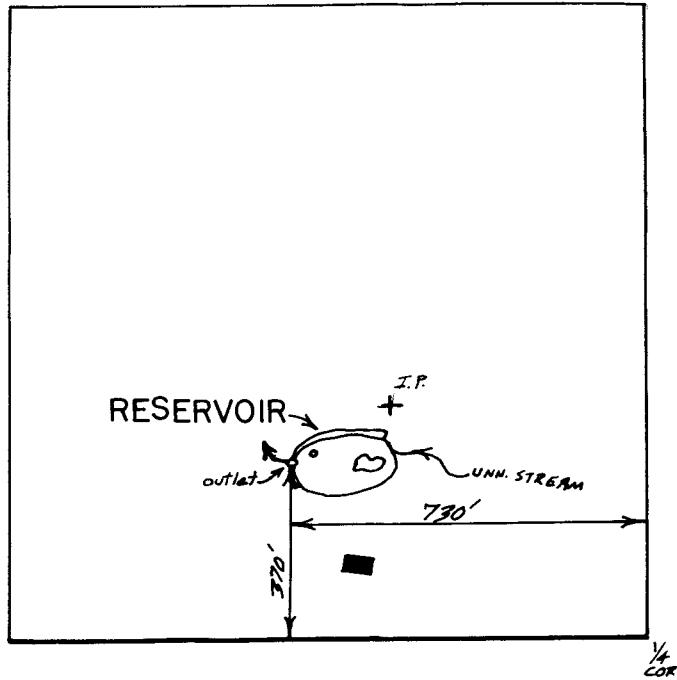

Scale 1" = 400'

FINAL PROOF SURVEY
UNDER

Application No. R-81379 Permit No. R-12199...
IN NAME OF

.....PATRICIA..... HENDRIX.....

Surveyed June 16, 1998, by B.R. SUND, N. DAFT.

BSD 7/98
June 1998