

No Final Proof Map Available  
See Permit Map  
through  
OWRD WrisQuery page

*All Scanned Documents*



TITLE INSURANCE  
ESCROWS

THIS MAP IS FURNISHED AS A CONVENIENCE IN LOCATING  
PROPERTY AND THE COMPANY ASSUMES NO LIABILITY FOR  
ANY DISCREPANCIES AS MAY BE DISCLOSED BY ACTUAL SURVEY

DEC - 6 1996

(541) 386-5300  
FAX (541) 386-2401

WATER RESOURCES DEPT.  
P.O. BOX 660, 114 CASCADE AVENUE  
HOOD RIVER, OREGON 97031

FILE NO. R-81756


1" = 400'

1N, 11E, SEC 6  
TAX LOTS 501, 600

Permit No. R12200

LOT 4  
e apparently in error  
led to 37.14 Ac.  
From 44.24 Ac.  
JUNE 1971

See Map 2N 11 31

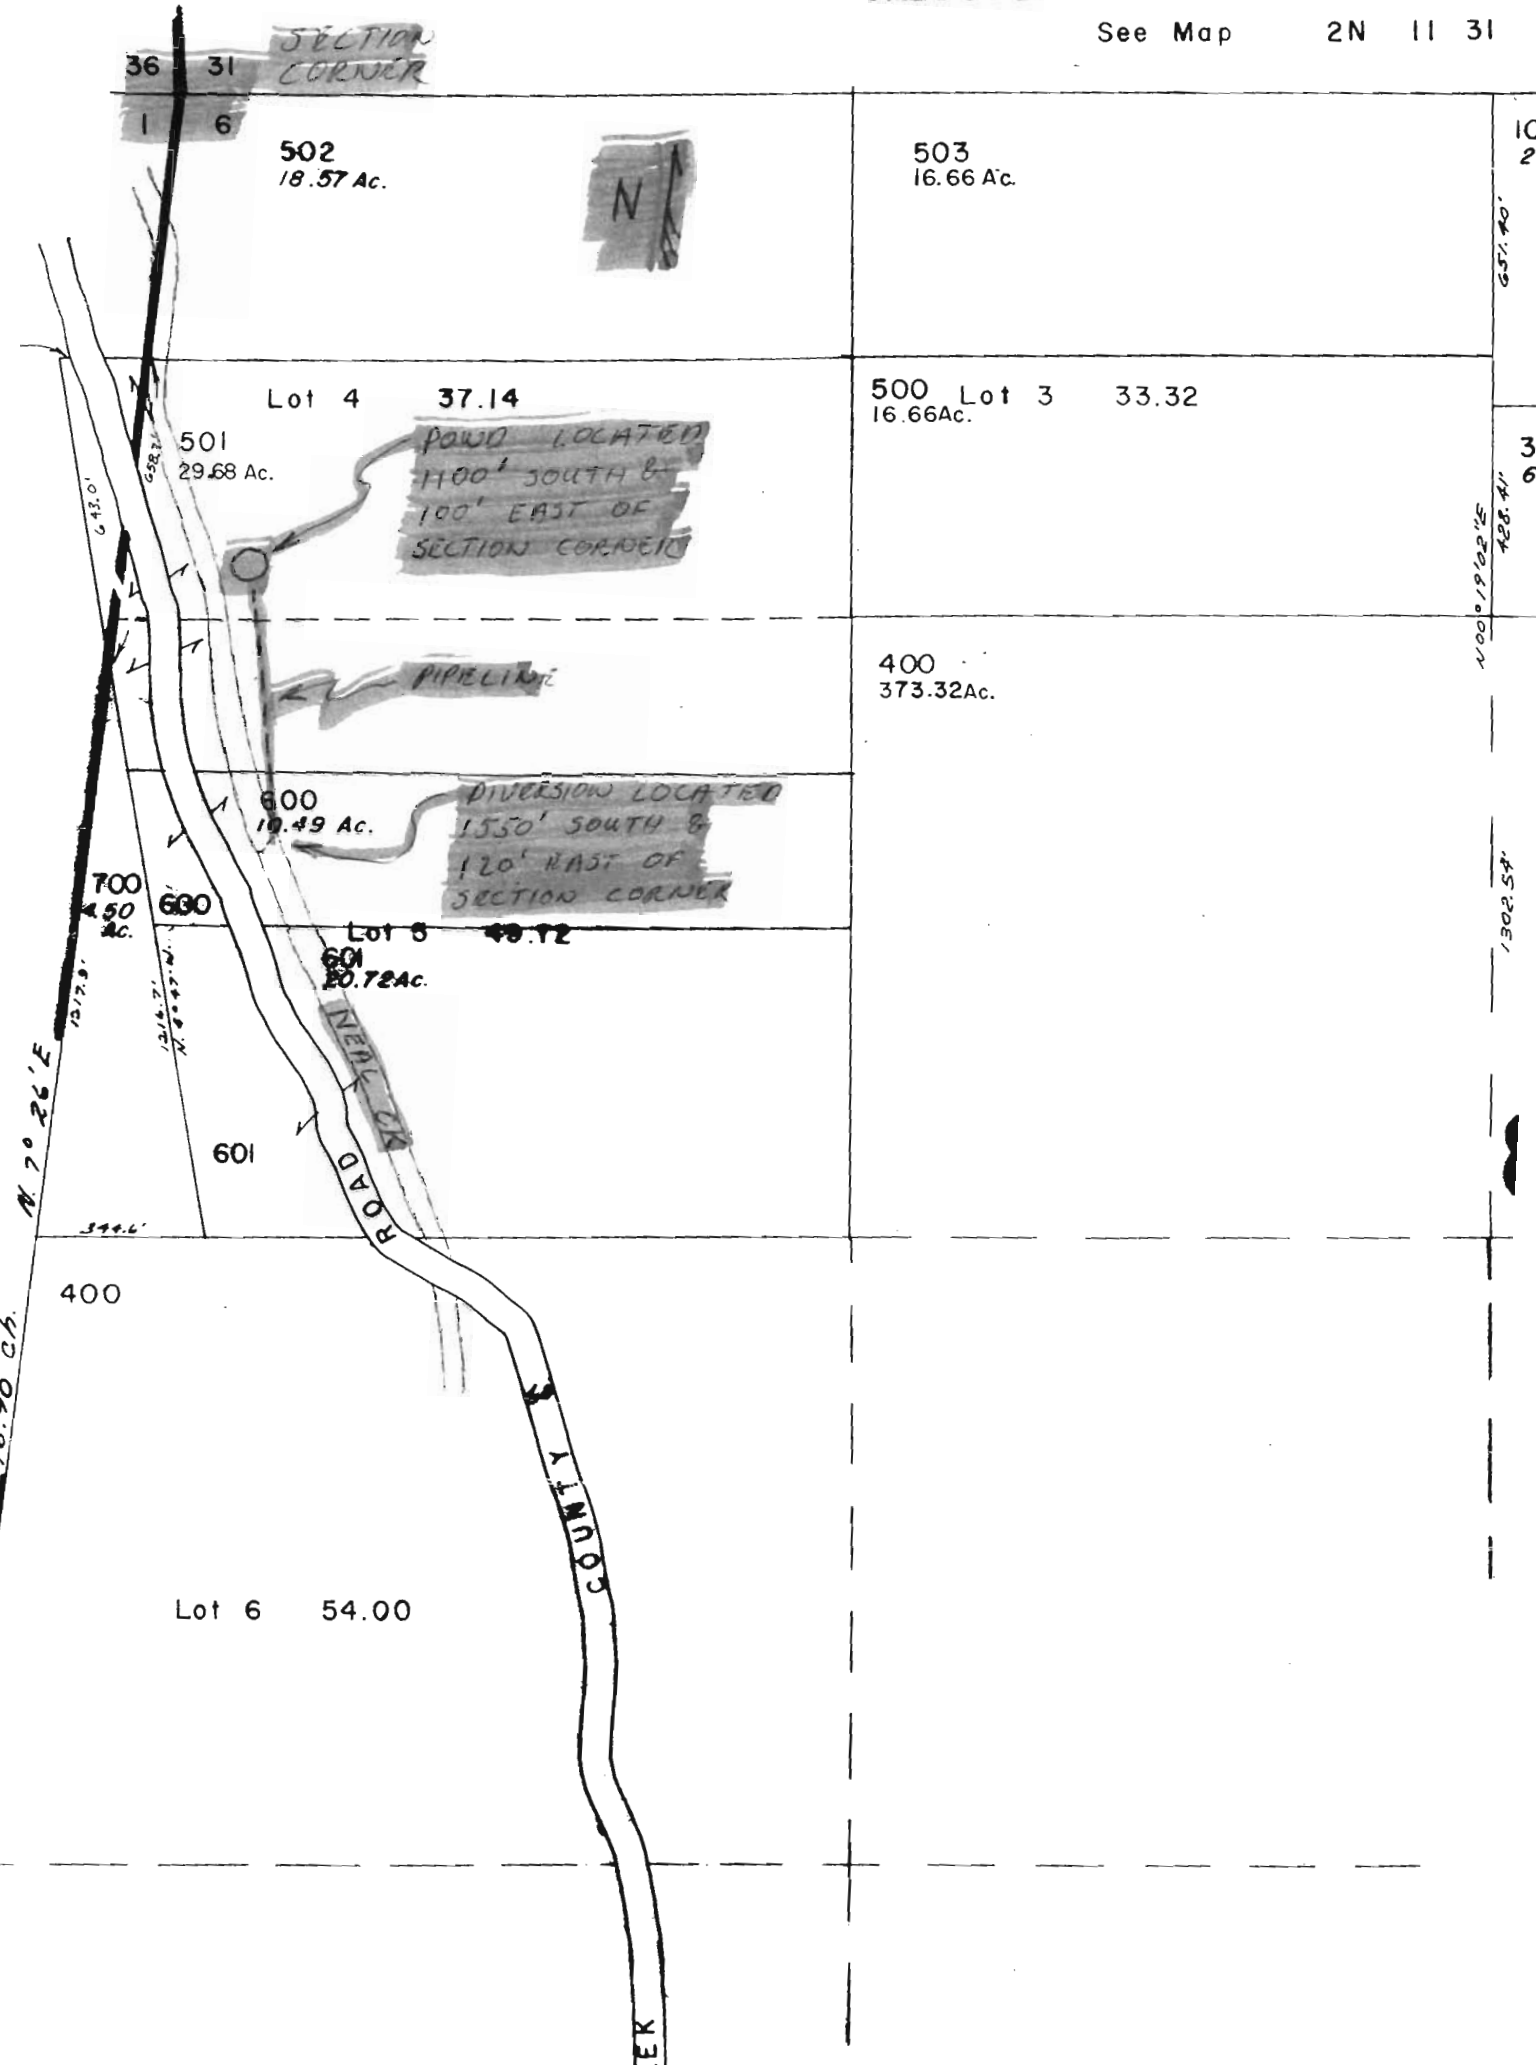

SECTION CORNER

36 31  
1 6

502  
18.57 Ac.

503  
16.66 Ac.

Lot 4 37.14

500 Lot 3 33.32  
16.66 Ac.

501  
29.68 Ac.

POUND LOCATED  
1100' SOUTH &  
100' EAST OF  
SECTION CORNER

PIPELINE

600  
19.49 Ac.

DIVERSION LOCATED  
1550' SOUTH &  
120' EAST OF  
SECTION CORNER

700  
4.50 Ac.

600

Lot 5 49.72

601  
20.72 Ac.

601

NEAL ROAD  
ROAD  
COUNTY ROAD

400

Lot 6 54.00