RECEIVED
DEC - 6 1996
WATER RESOURCES DEPT.
SALEM, OREGON

THIS MAP IS FURNISHED AS A CONVENIENCE IN LOCATING PROPERTY AND THE COMPANY ASSUMES NO LIABILITY FOR ANY DISCREPANCIES AS MAY BE DISCLOSED BY ACTUAL SURVEY.

RECEIVED
DEC - 6 1996
WATER RESOURCES
OREGON

COLUMBIA TITLE COMPANY
TITLE INSURANCE
ESCROWS
(541) 386-5300
FAX (541) 386-2401
P.O. BOX 660 - 114 CASCADE AVENUE
HOOD RIVER, OREGON 97031

1S, 10E, SEC 5, TL 305

FILE NO. R-81757

Permit No. R12201 (reduced to 85% by Columbia Title)

Sec. 5 T1S R10E WM
Hood River County
1" = 400'
See Map 1N 10 33

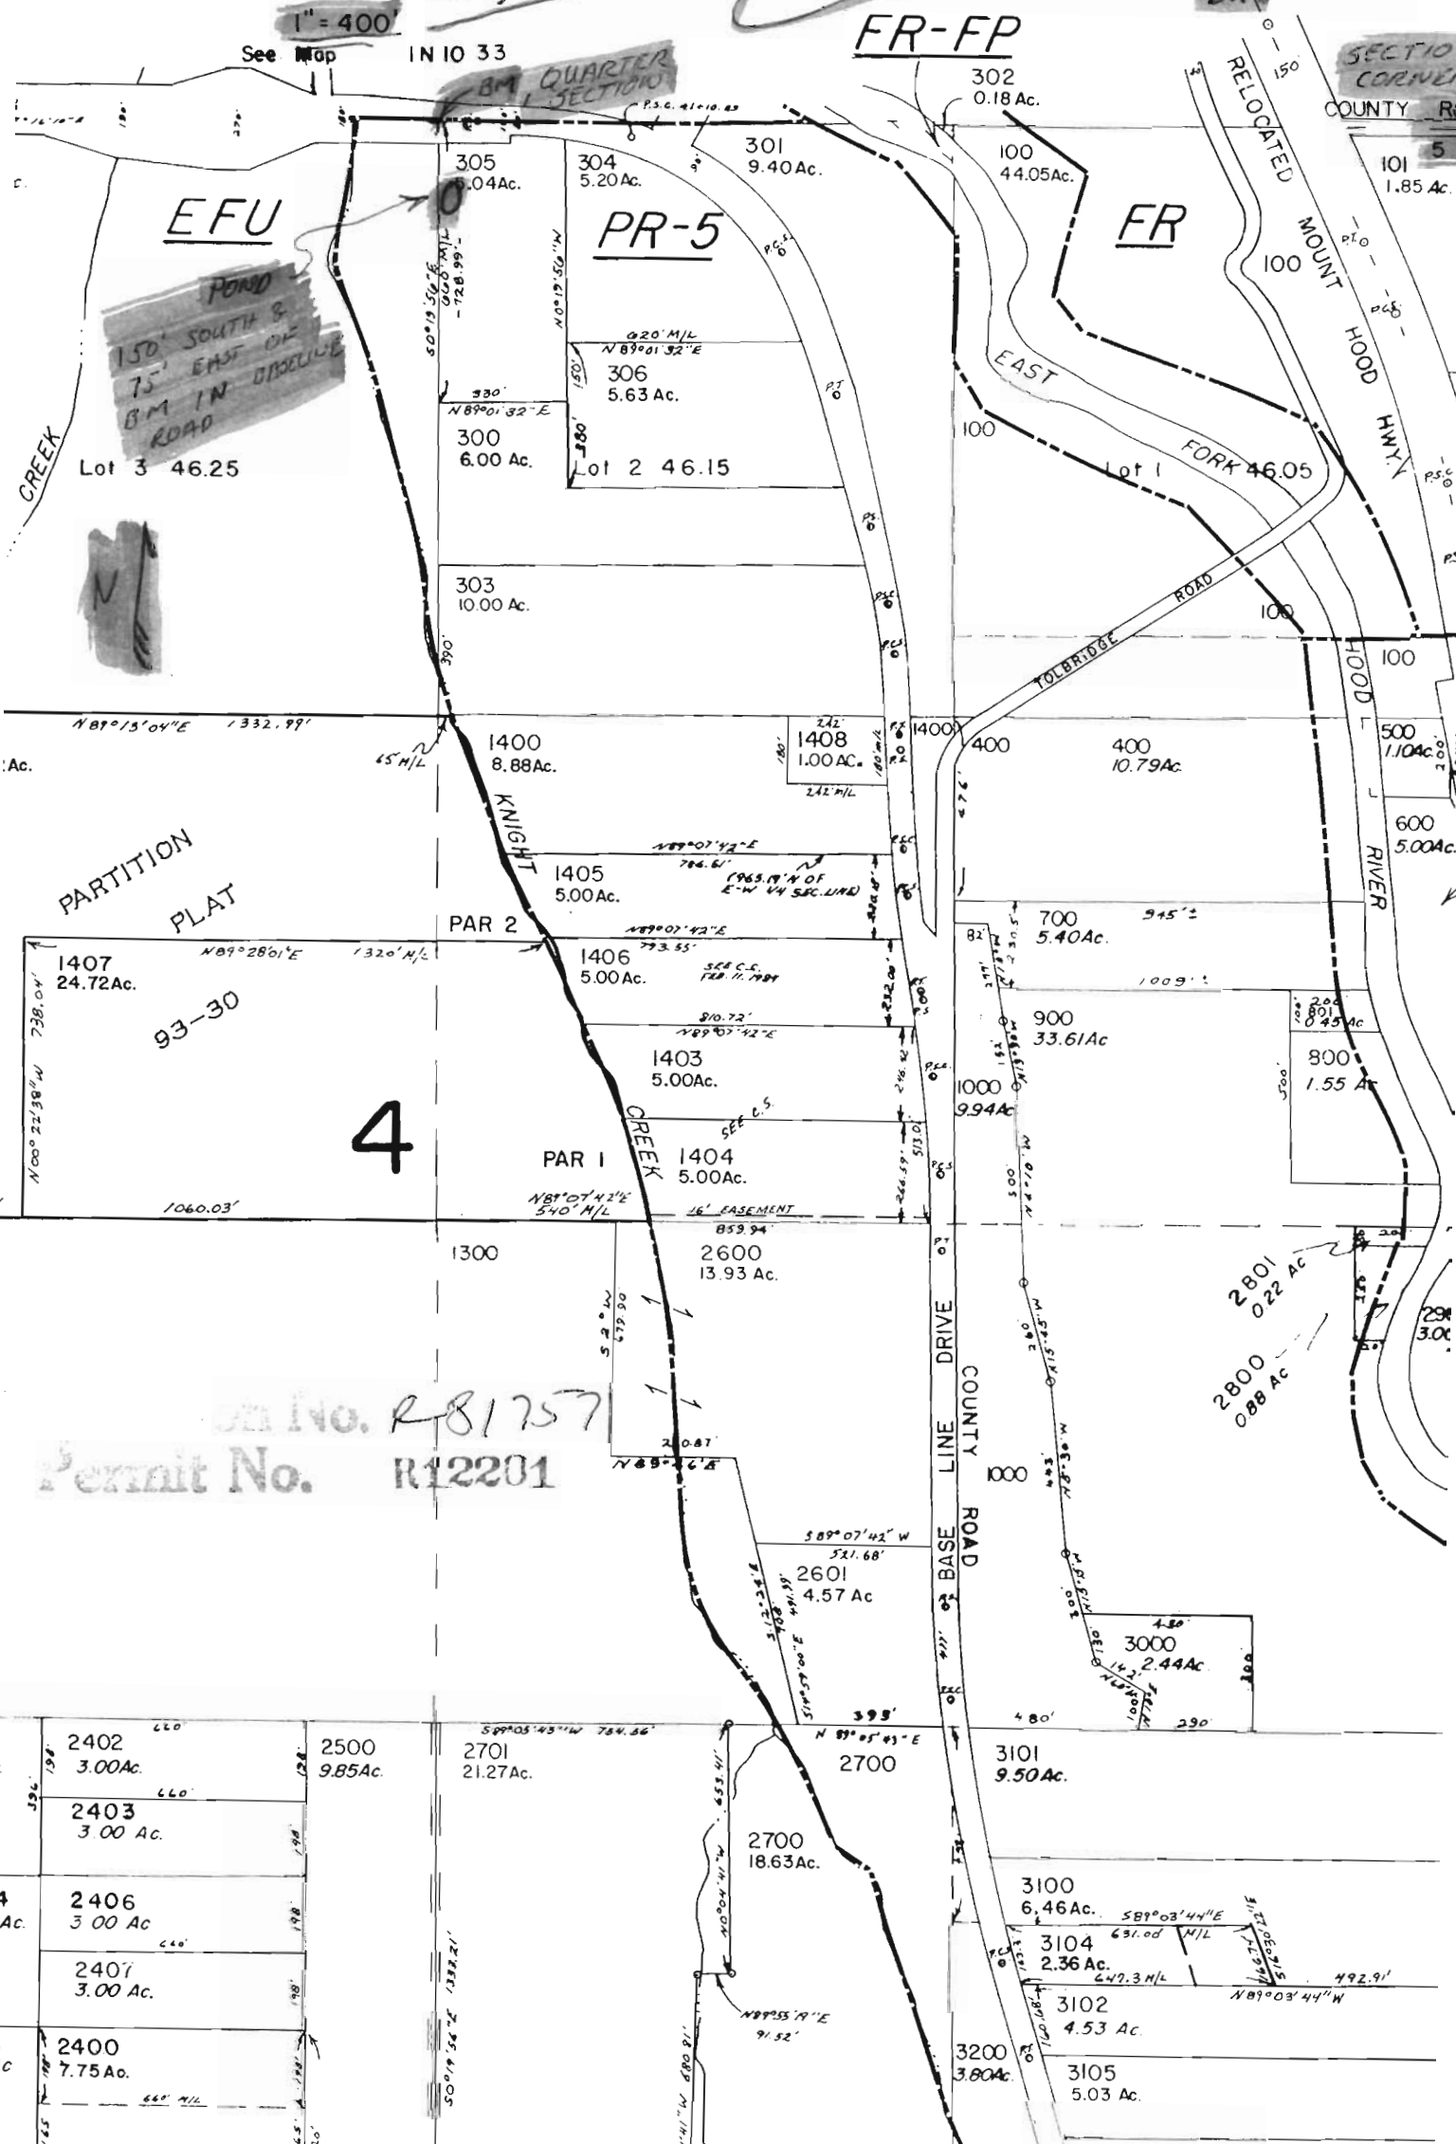

File No. R-81757
Permit No. R12201

No Final Proof Map Available
See Permit Map
through
OWRD WrisQuery page

All Scanned Documents