


Application no. 80987 + R-80988  
Permit No. 53274

R12321

FEB 26 1996

WATER RESOURCES DEPT.  
SALEM, OREGON

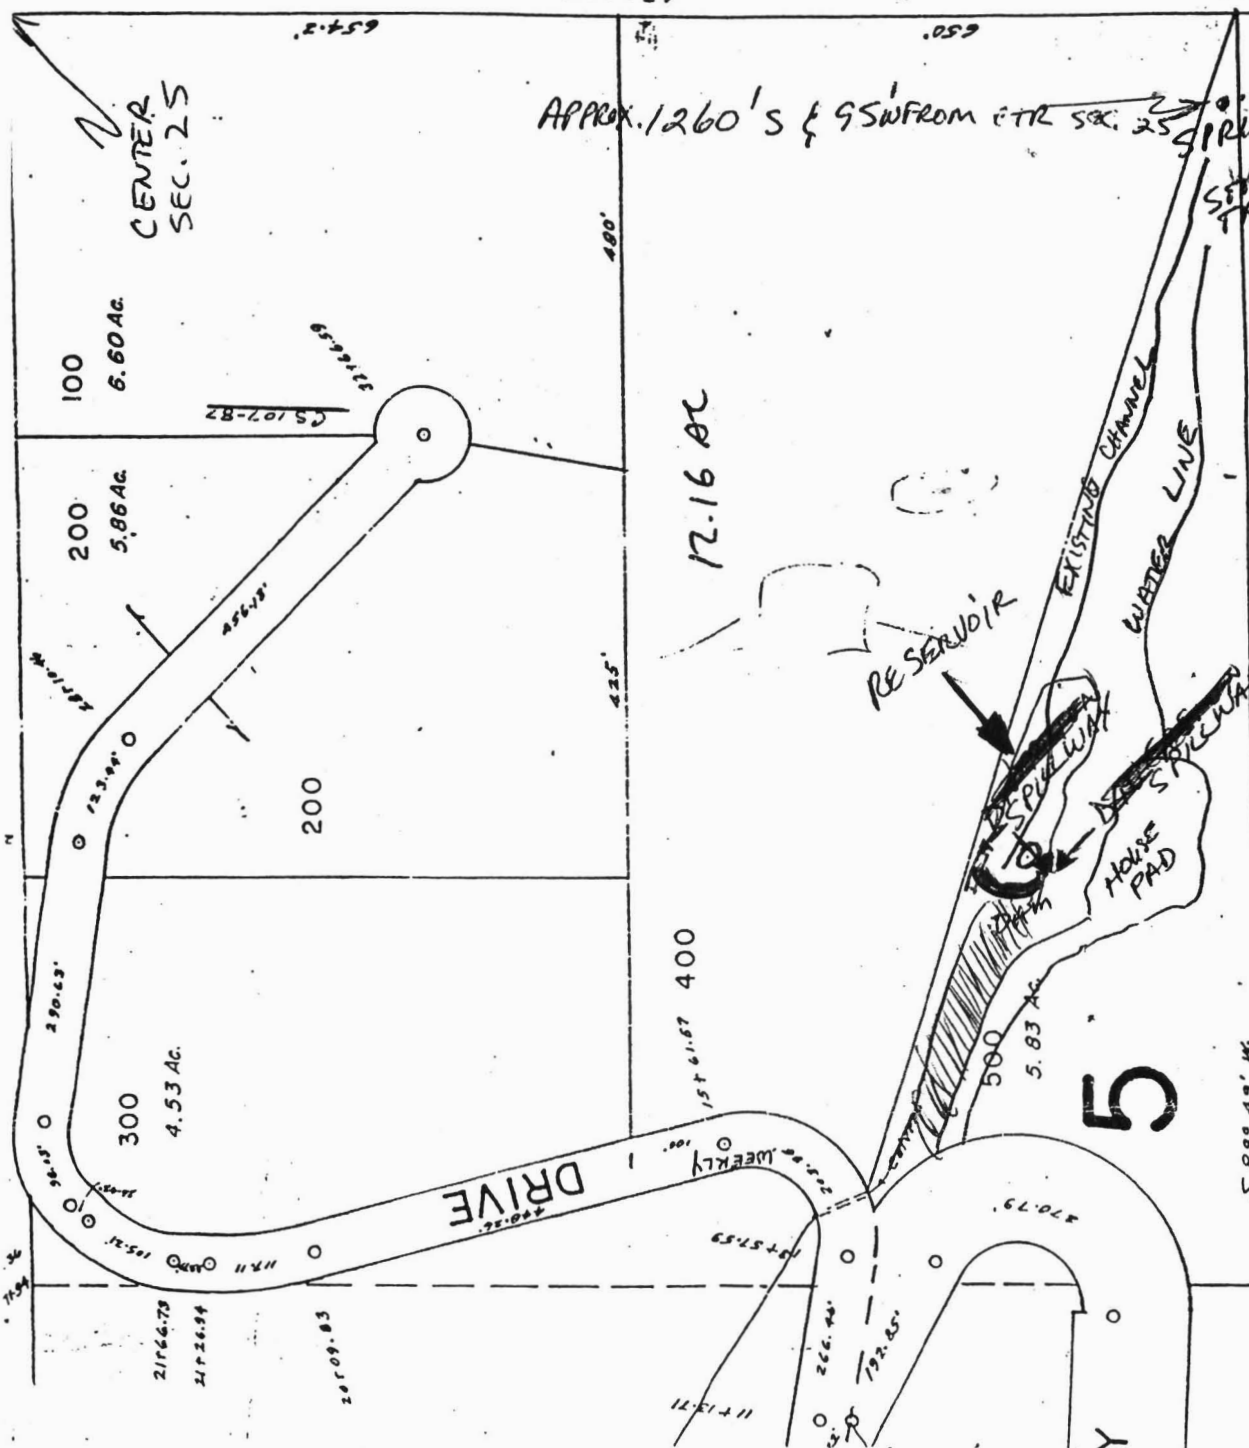

APPROX. 1260'S & 95' SW FROM ETR SEC. 25

RECEIVED

MAR 31 1997  
WATER RESOURCES DEPT.  
SALEM, OREGON

RECEIVED

APR 15 1997  
WATER RESOURCES DEPT.  
SALEM, OREGON

LEGAL DESCRIPTION

36-07-25 TAX LOT 500 - 5.83 ACRES

- IRRIGATED AREA
- POINT OF DIVERSION

NOTE: POD IS APPROX. 1000'S AND 850' W OF CENTER OF SEC. 25.