


SEE MAP 39 19

CANCELLED NUMBERS  
200

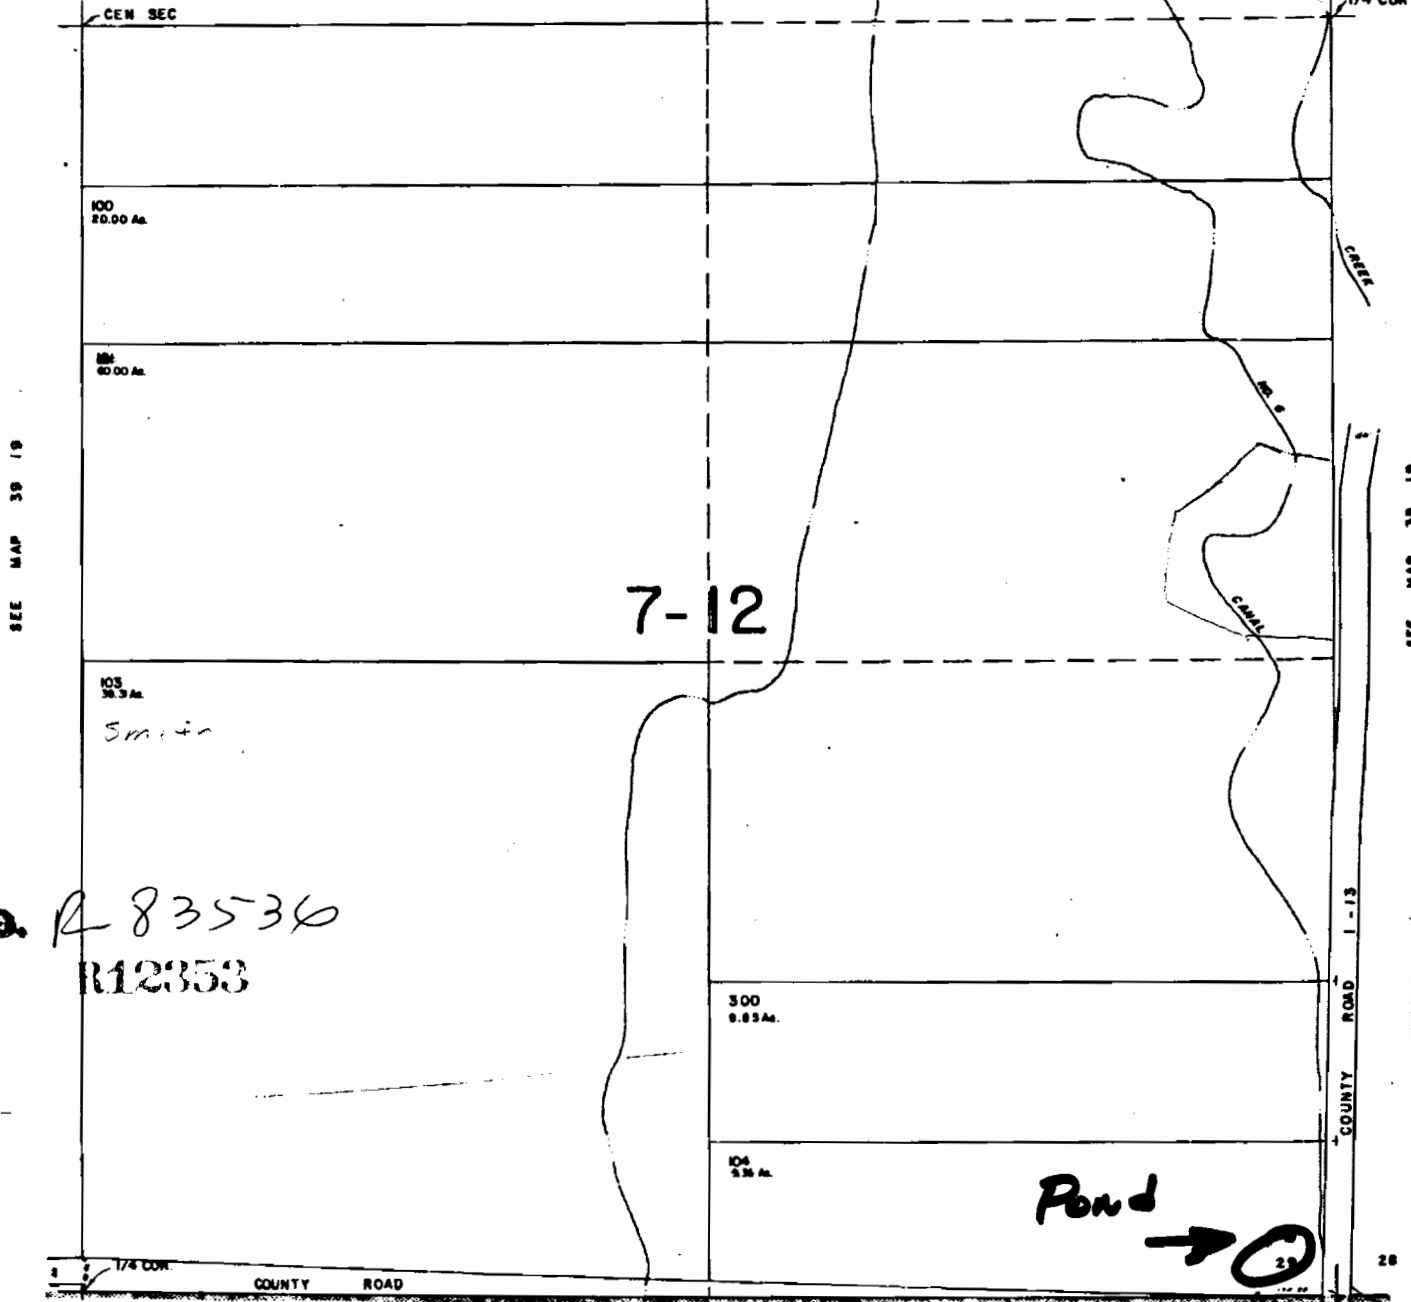

Application No. R 83534  
 Permit No. R12353

AUG 25 1997

WATER RESOURCES DEPT.  
SALEM, OREGON

RECEIVED