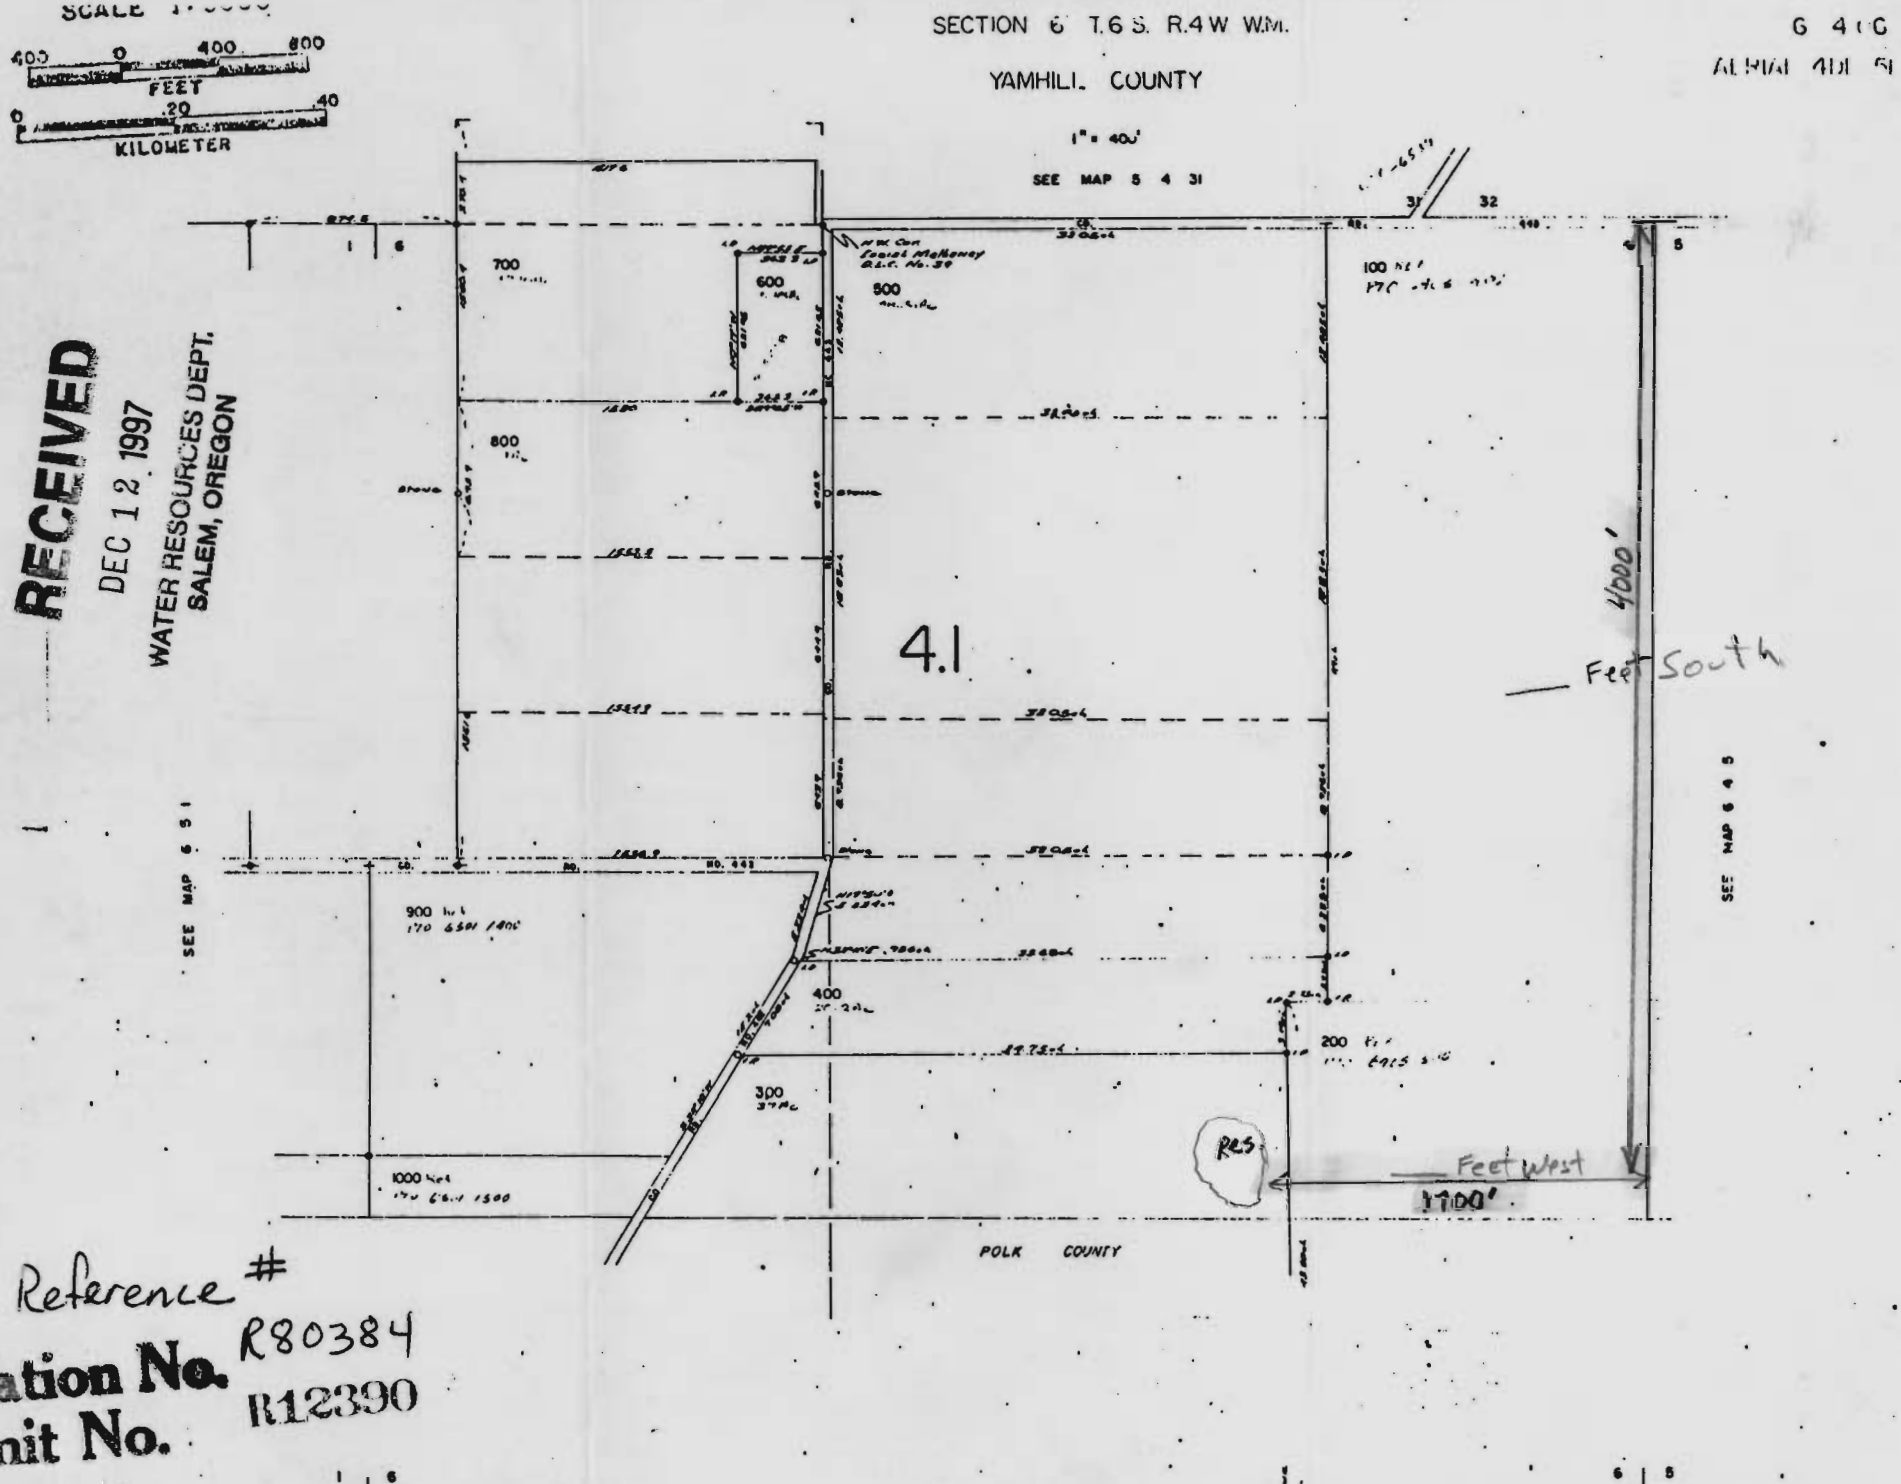

Reference # R80384

Application No. R12390

Permit No.