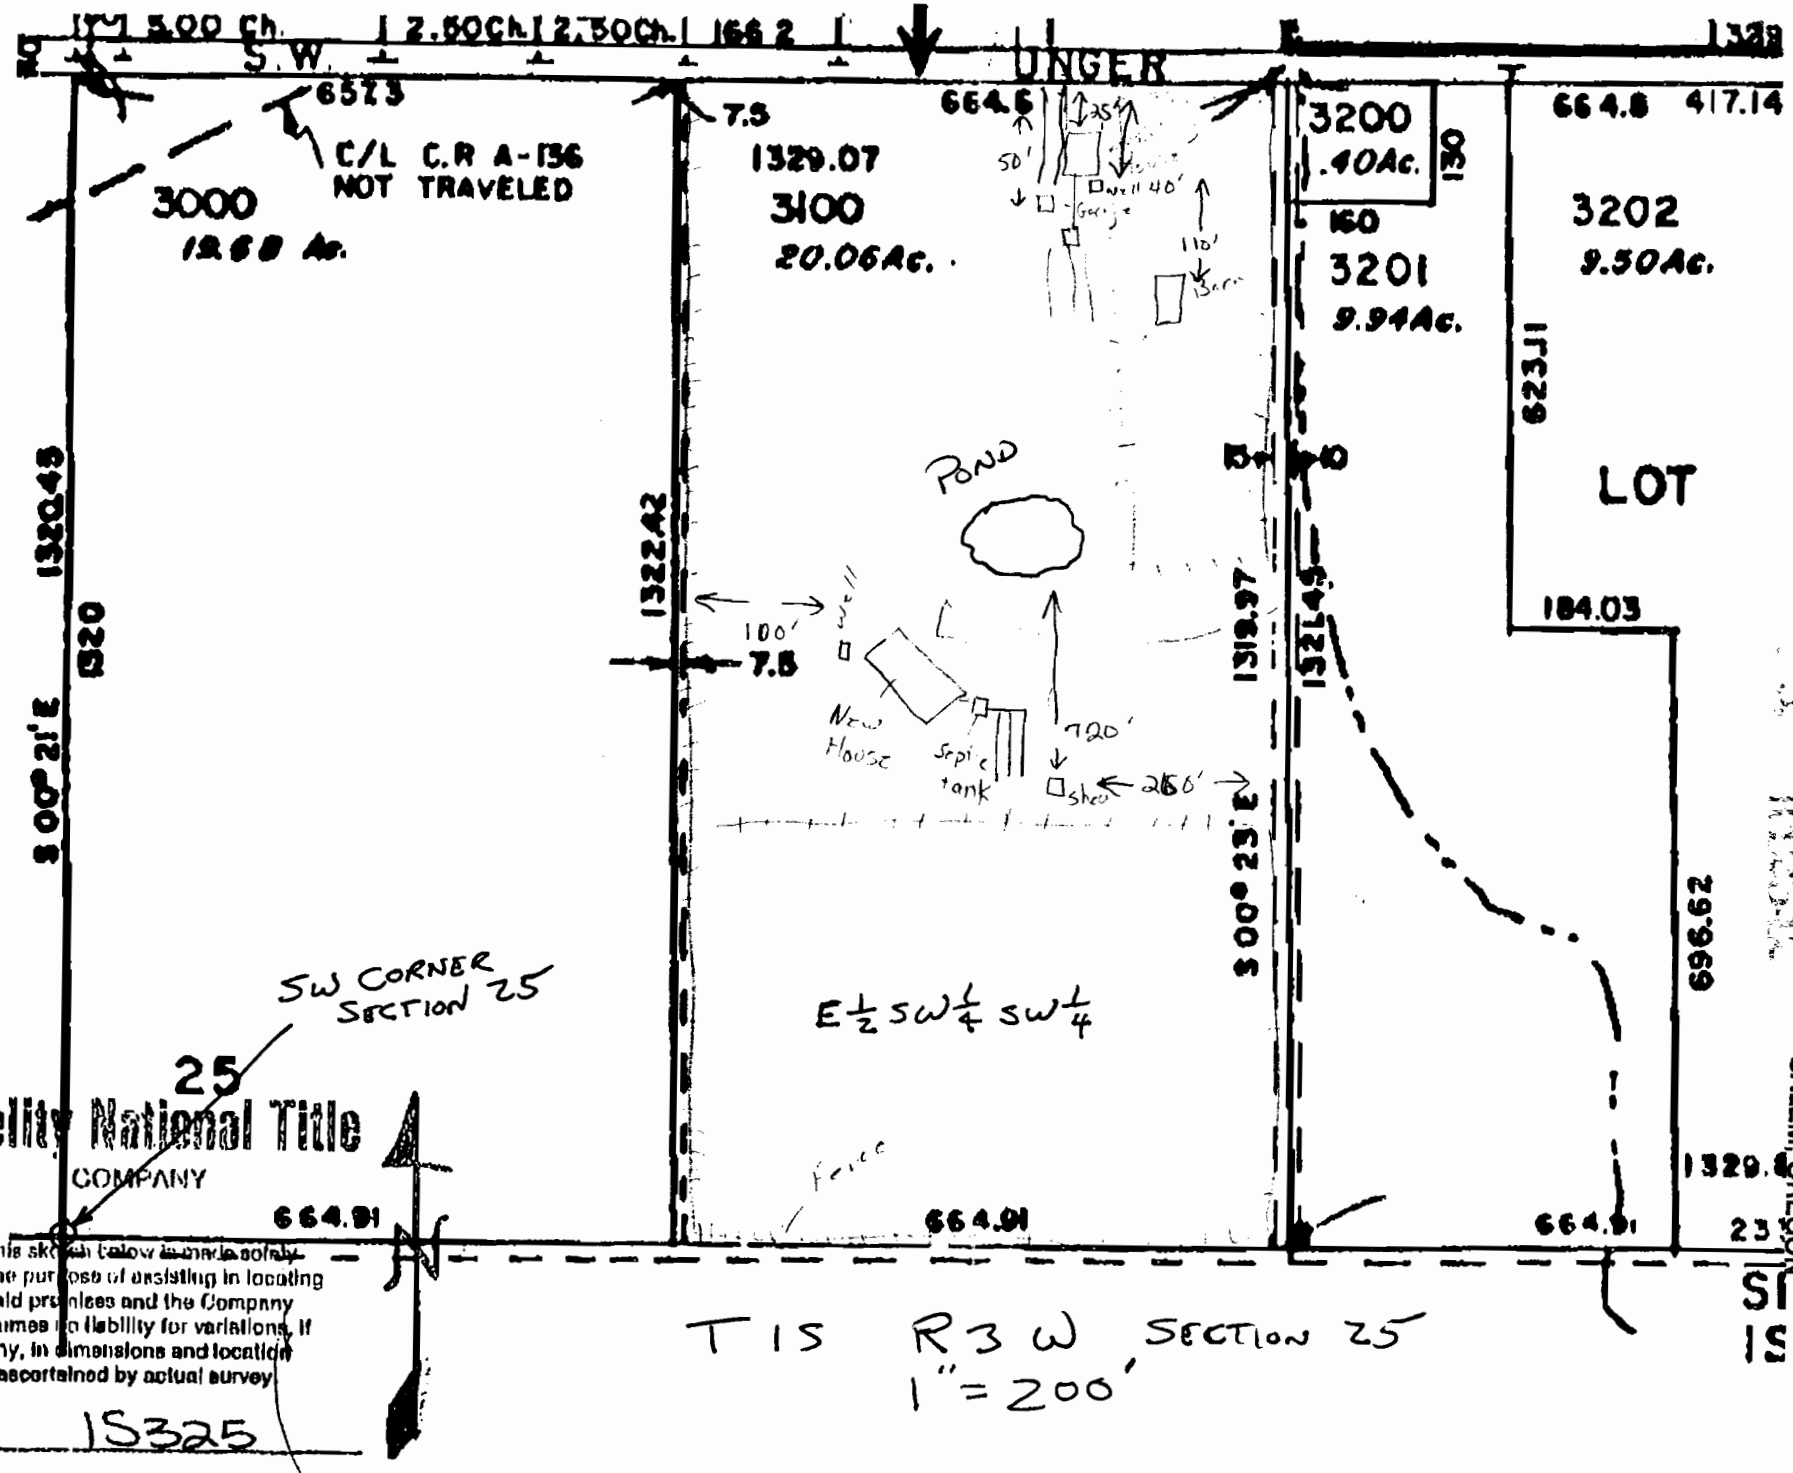

Fidelity National Title COMPANY

This sketch below is made solely for the purpose of assisting in locating said premises and the Company assumes no liability for variations, if any, in dimensions and location ascertained by actual survey

MAP # 1S325

RECEIVED
APR - 8 1998
WATER RESOURCES DEPT.
SALEM, OREGON

No. R 83802