

This sketch is provided, without charge, for your information. It is not intended to show all matters related to the property including, but not limited to, area, dimensions, easements, encroachments, or location of boundaries. It is not a part of, nor does it modify, the commitment or policy to which it is attached. The Company assumes no liability for any matter related to this sketch. Reference should be made to an accurate survey for further information.

SECTION 36
LINCOLN

THIS MAP WAS
ASSESSMENT I

Order Number: 122132 Scale 1" = 400'
County Assessor's Map 7-11-36 PTV TL 600

Application R 83874
Permit R-12674


RECEIVED

N↑

SEE M.

JUN 24 1998

WATER RESOURCES DEPT.
SALEM, OREGON

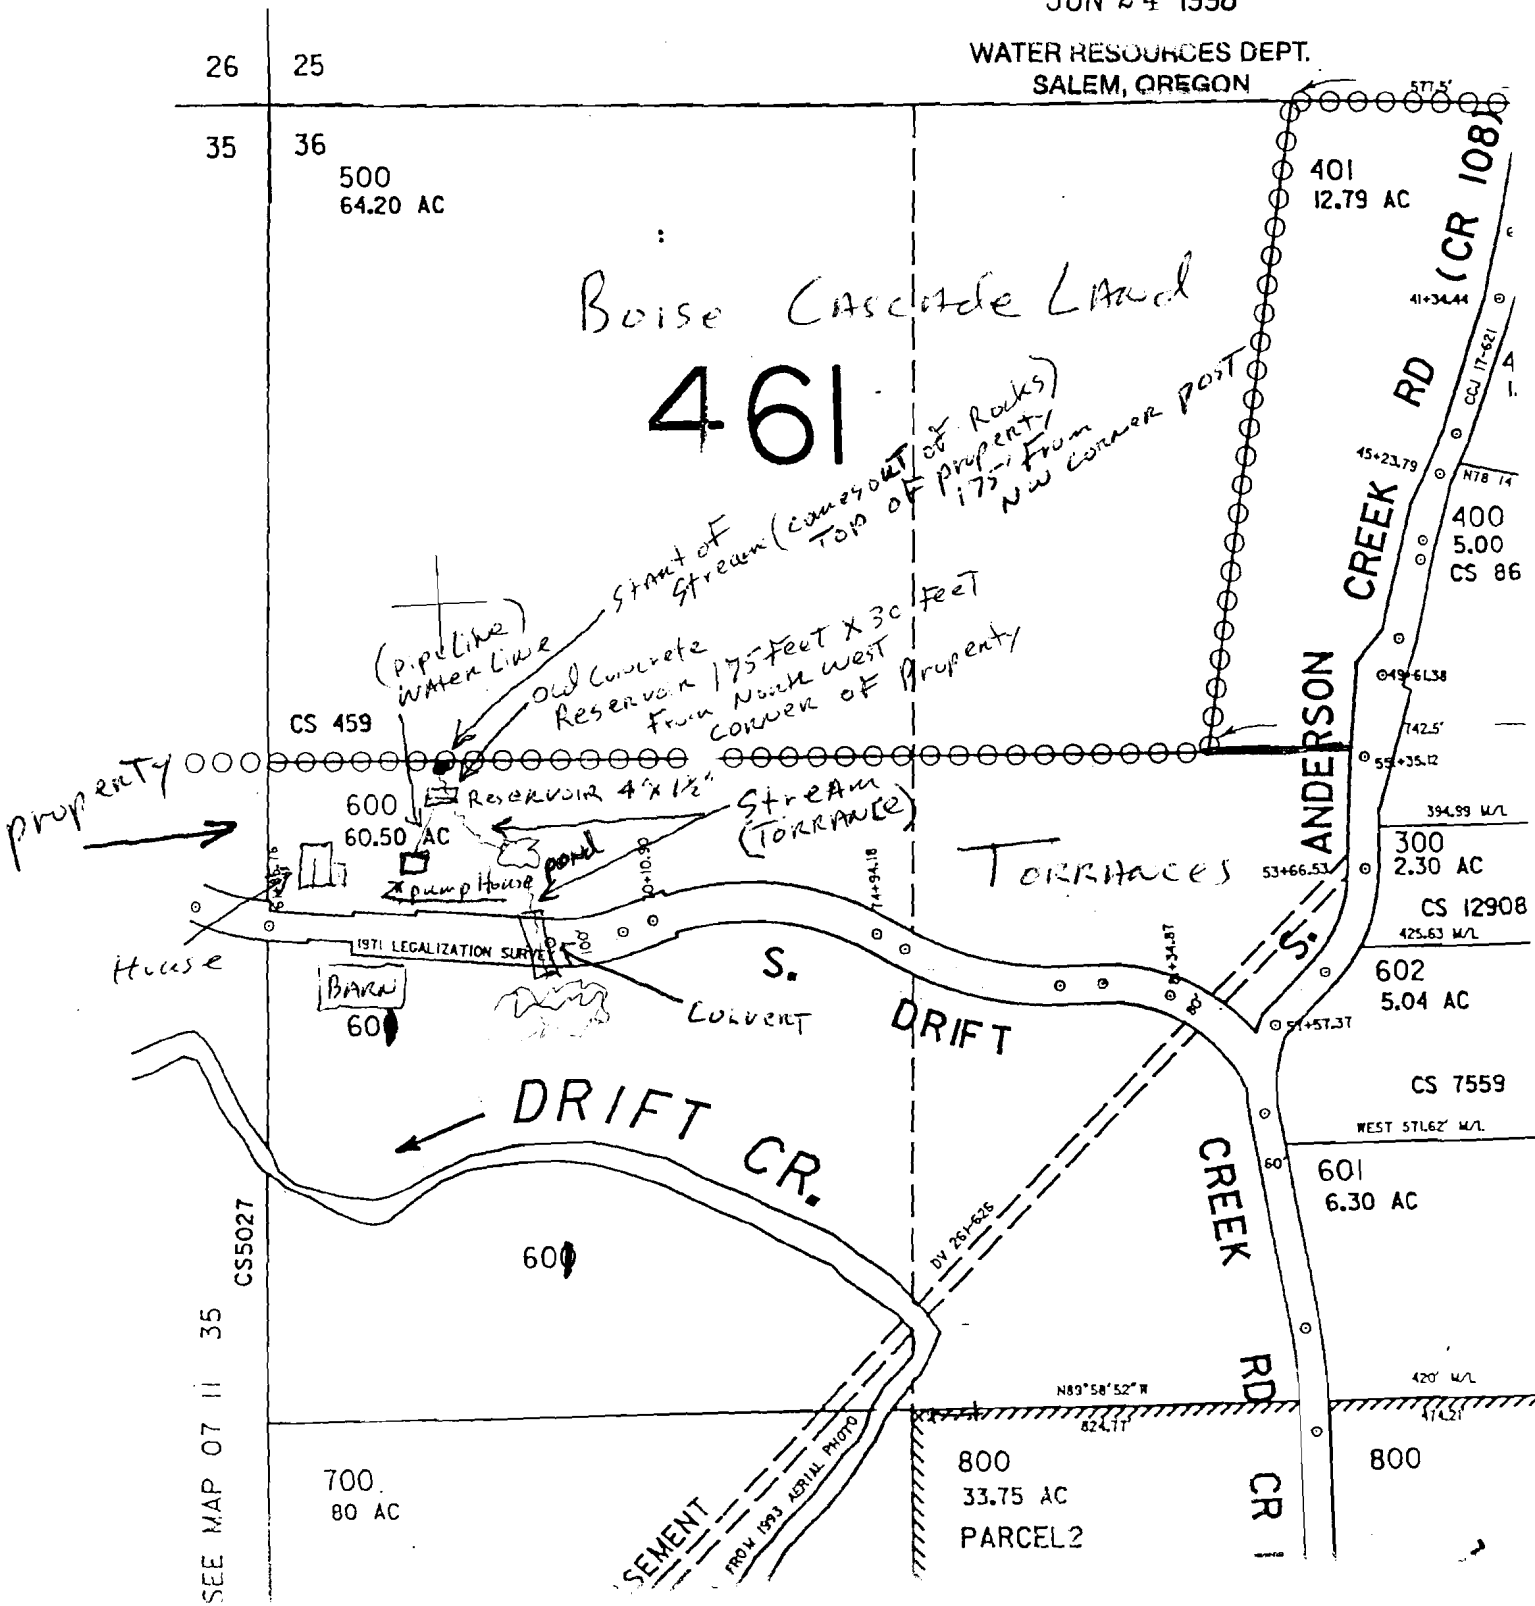

SEE MAP 07 11 35