


# T21S, R20E, WM T21S, R21E, WM

RECEIVED

JAN 12 1998

WATER RESOURCES DEPT.  
SALEM, OREGON

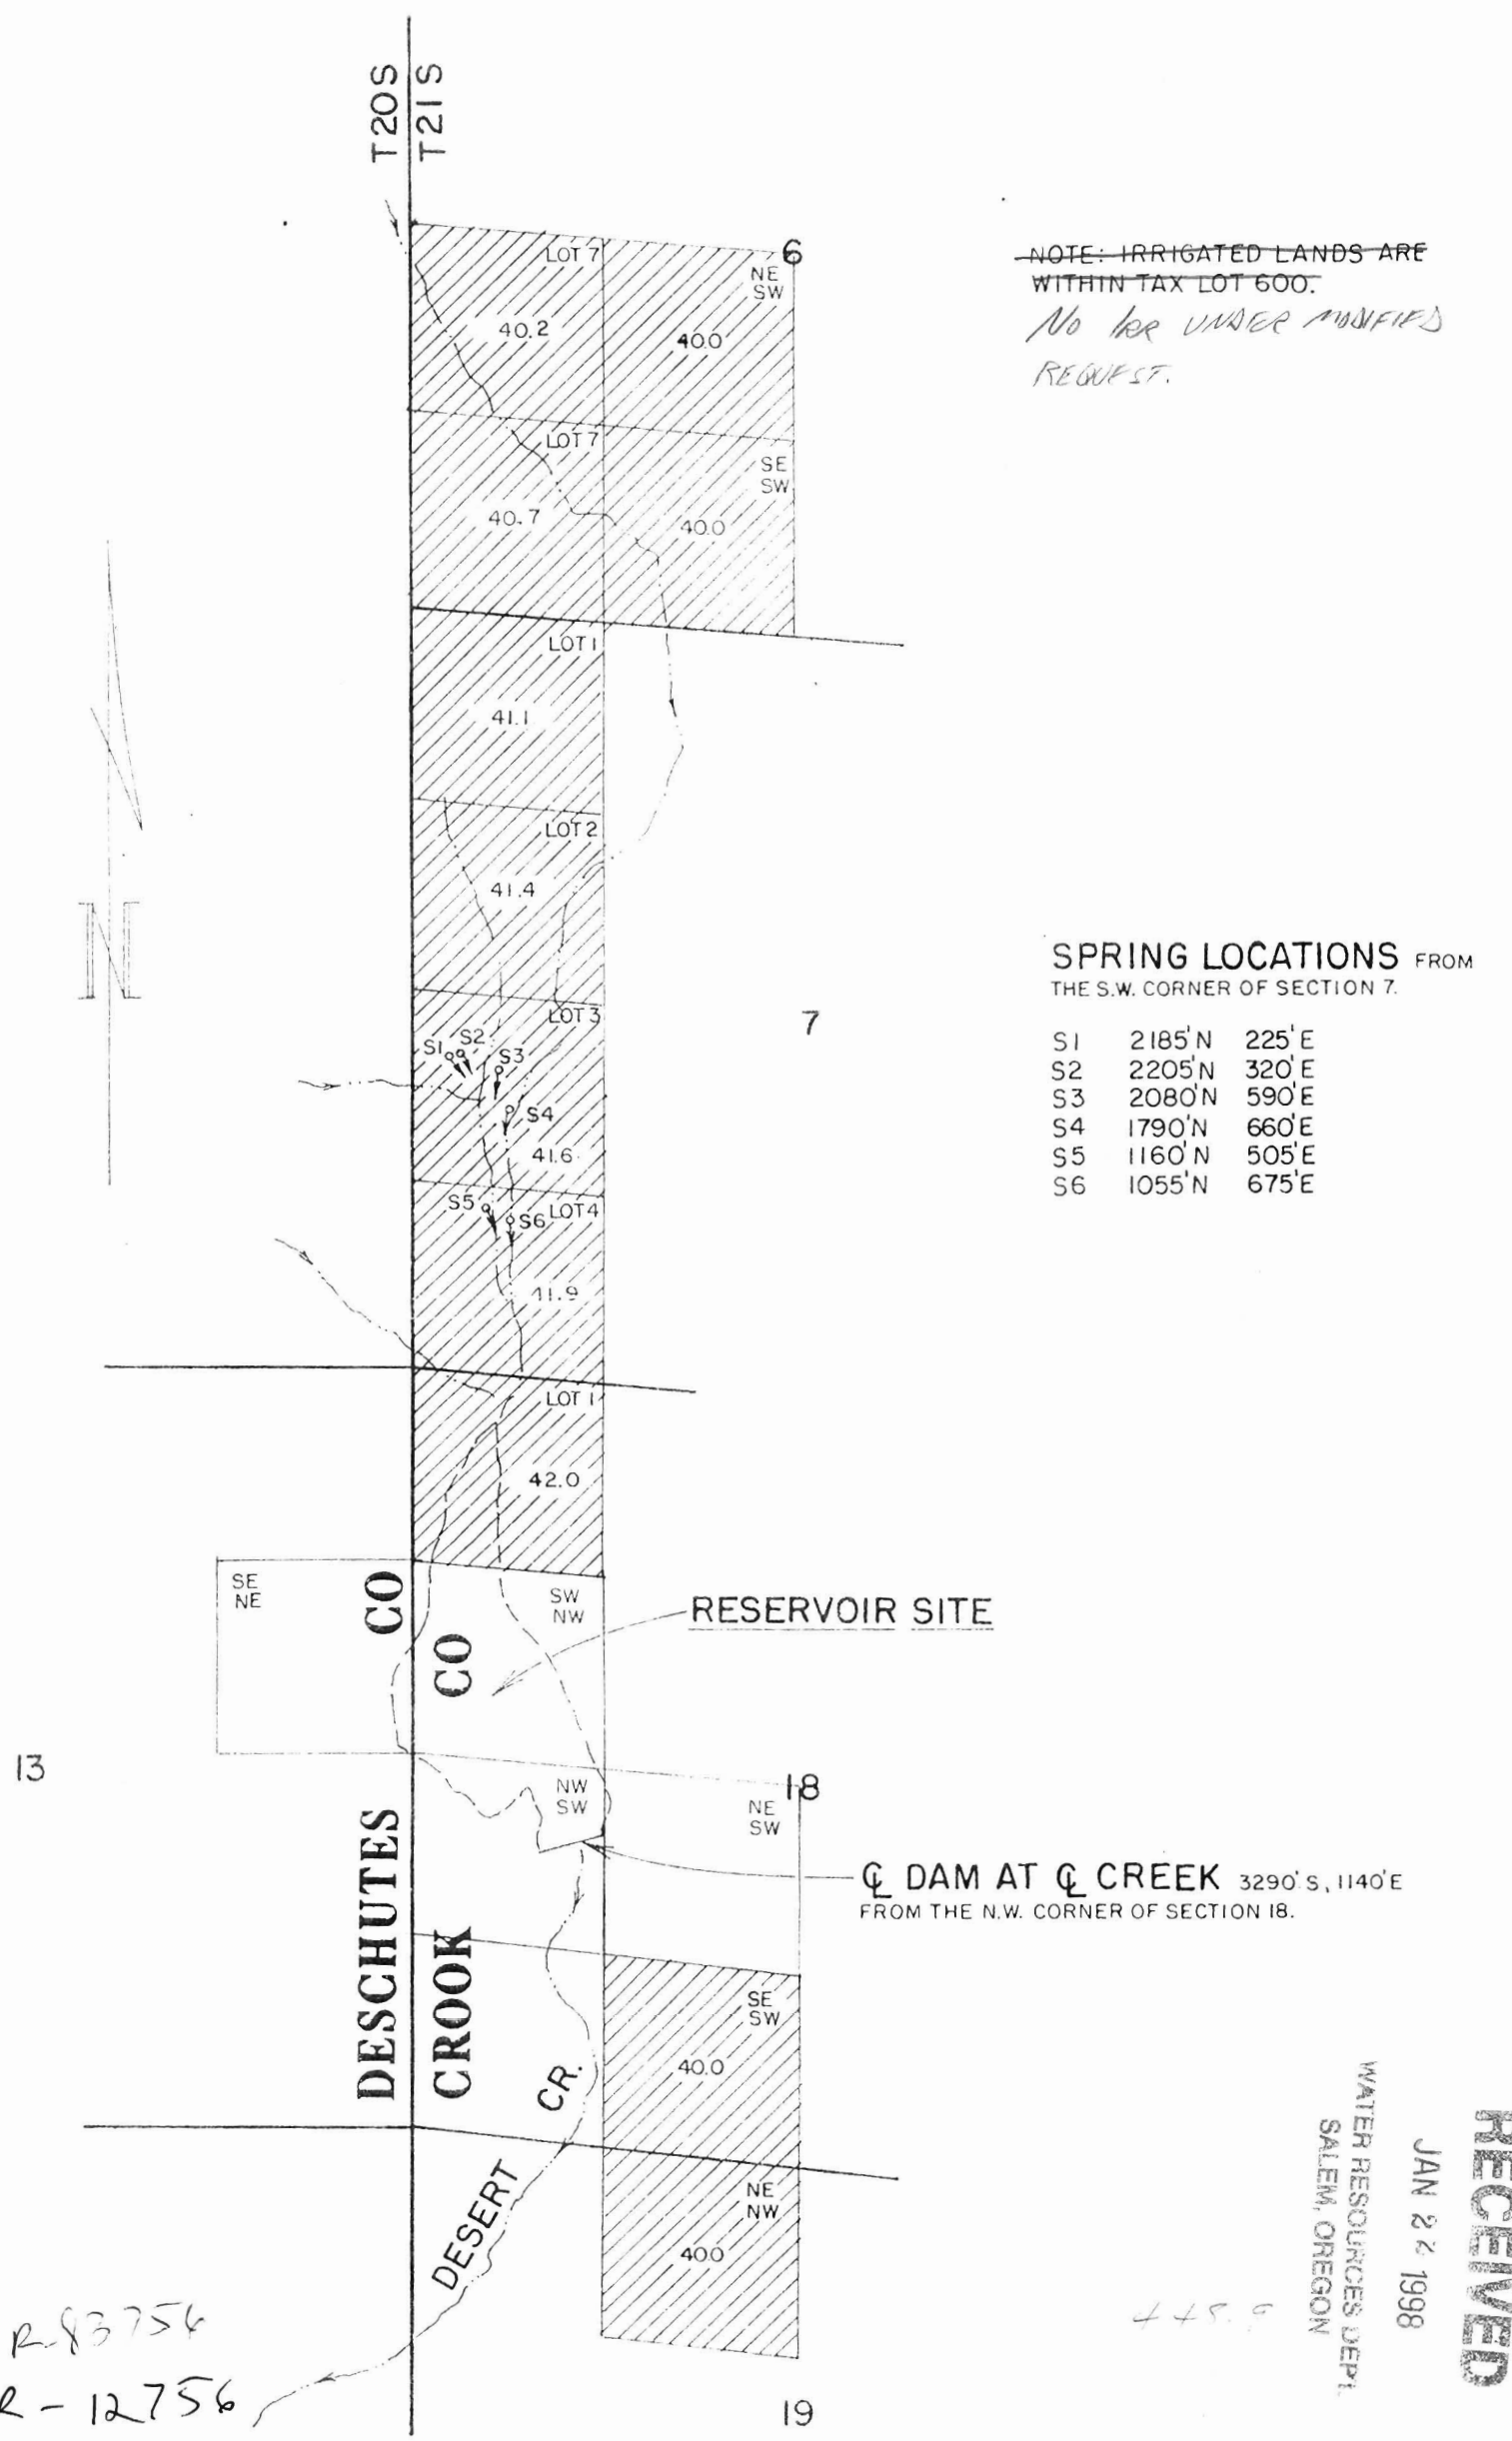

No. R-83756  
No. R-12756

RECEIVED  
JAN 22 1998  
WATER RESOURCES DEPT.  
SALEM, OREGON

	R. L. COATS		
	WATER RIGHT APPLICATION MAP		
	Scale: 4" = 1 MILE	Date: JAN. 6, 1998	
	Job: 1740	Sht. No.	
Dsn:		254 N. Alder - Box 61 Burns, Oregon 97720	
Drn: CHRIS			of
Ckd:			of