


SEE MAP IN 42 11CB

CANCELLED NO'S:  
2700

IN 42 11CC

SCALE 1:2400

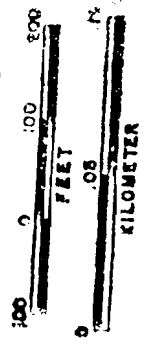


RECEIVED

JUL 31 1998

WATER RESOURCES DEPT.  
SALEM, OREGON

SEE MAP IN 42 11CB

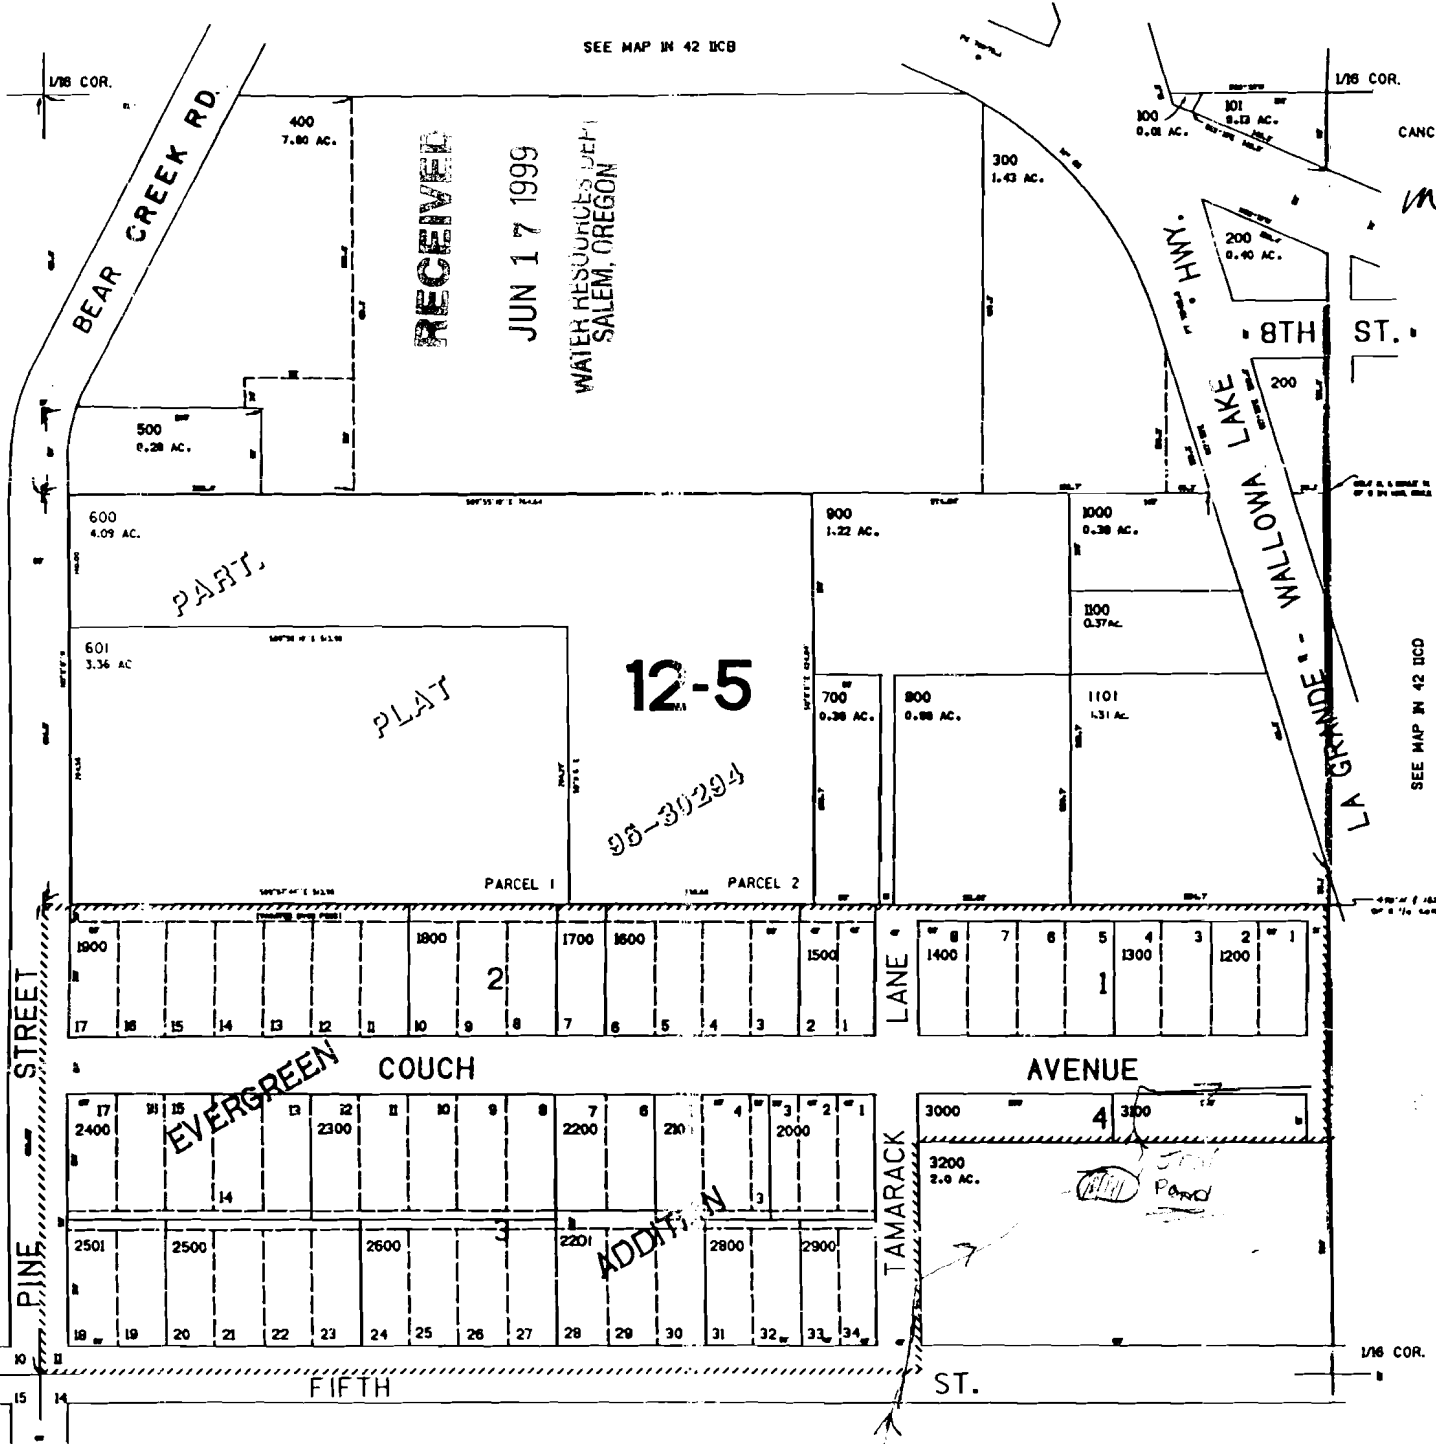

RECEIVED

OCT 25 1996  
DEPT. OF REVENUE  
STATE OF OREGON

A-R-84201  
P-R-12788

SEE MAP IN 42 148B