


THIS MAP FOR ASSESSMENT & TAXATION PURPOSES ONLY

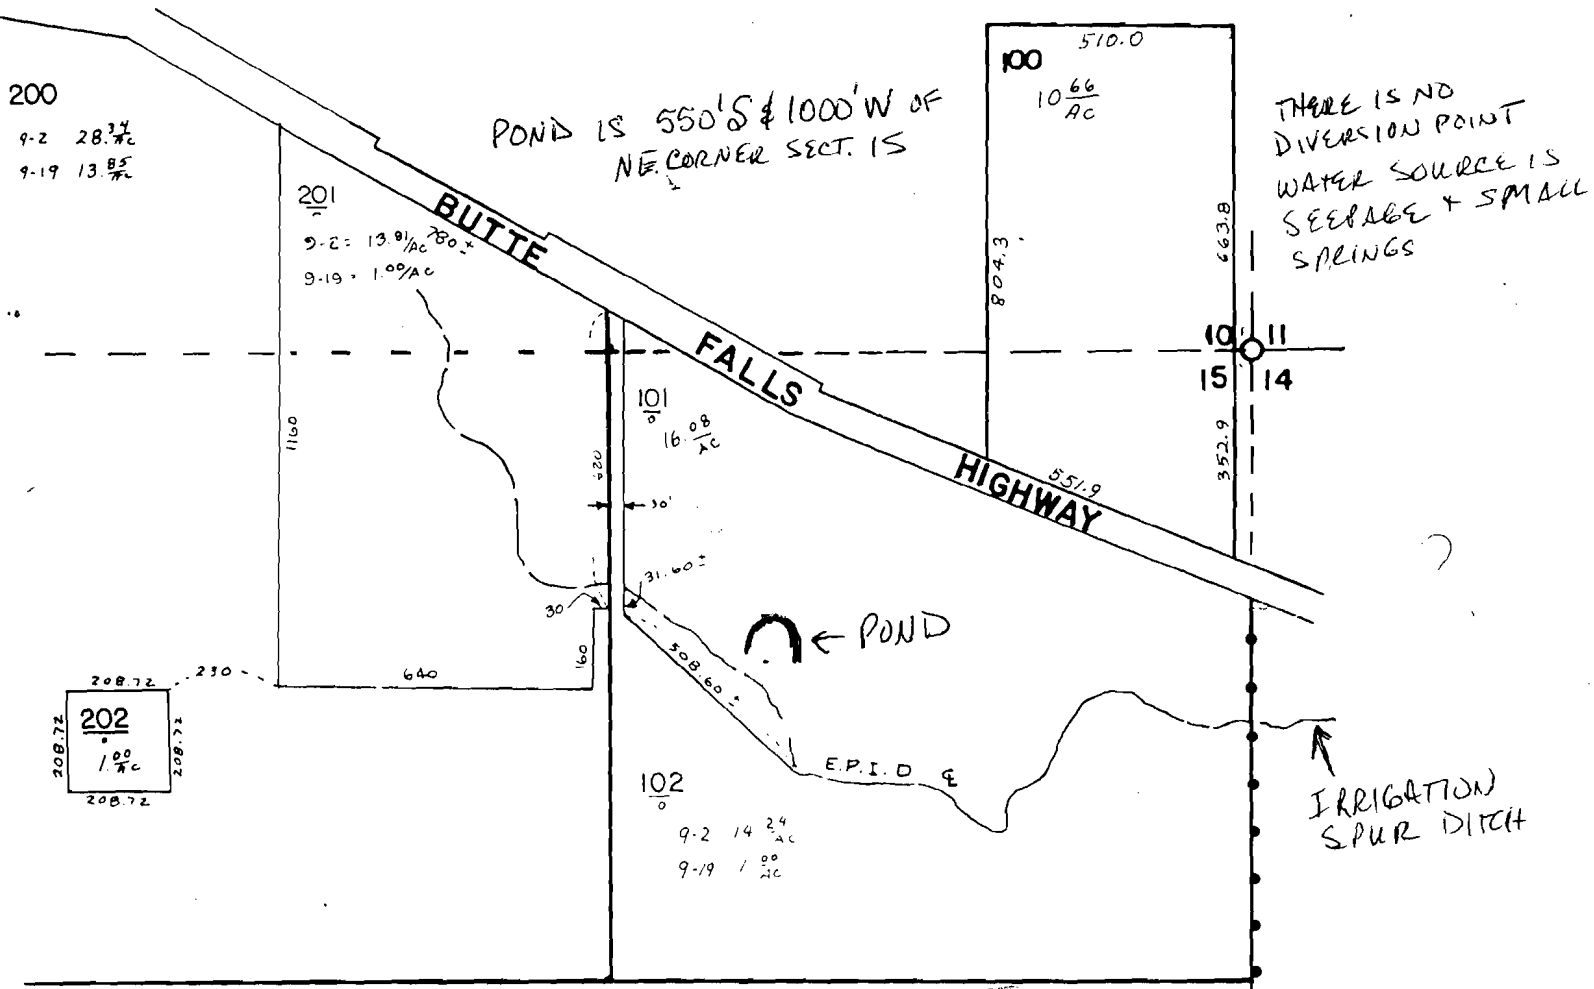

SCALE
1" = 400'



RECEIVED

JUN 15 1999

WATER RESOURCES DEPT.
SALEM, OREGON

9-19

OSR

S.W. COR. DLC 41

N.W. COR. DLC 42

Application R-54176
Permit No. R-12789

589 50-54E
135+0+2

200
0.54 Ac

11