

RECEIVED

DEC 27 1999


WATER RESOURCES DEPT
SALEM, OREGON

SEE MAP 40 9 24

T 40s R 8W

1" = 400'

JOSEPHINE COUNTY

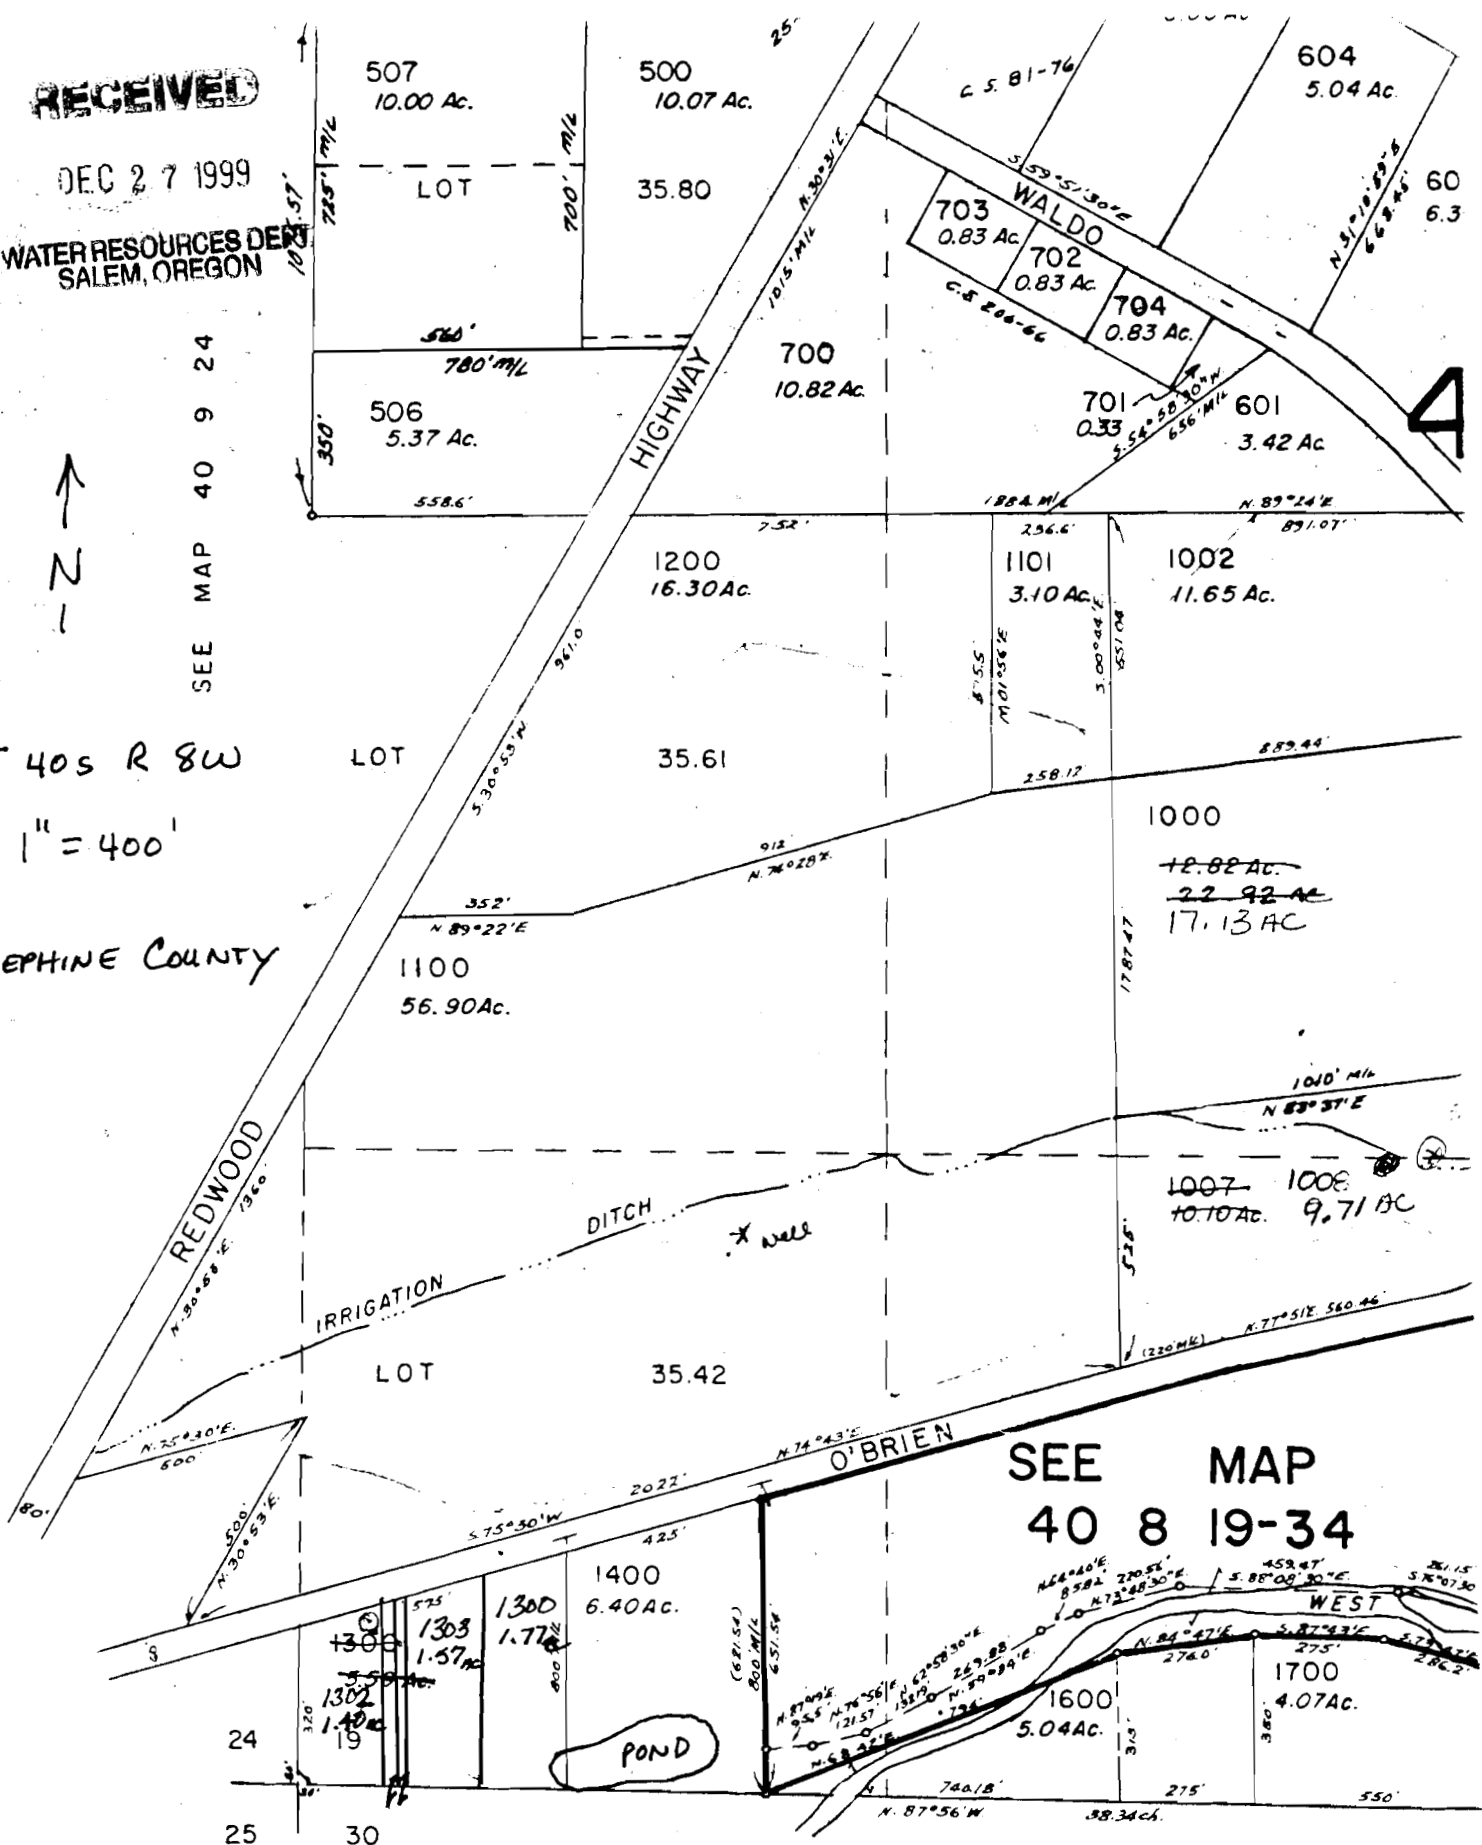

SEE MAP
40 8 19-34

R-84322
R-12897

SEE MA