
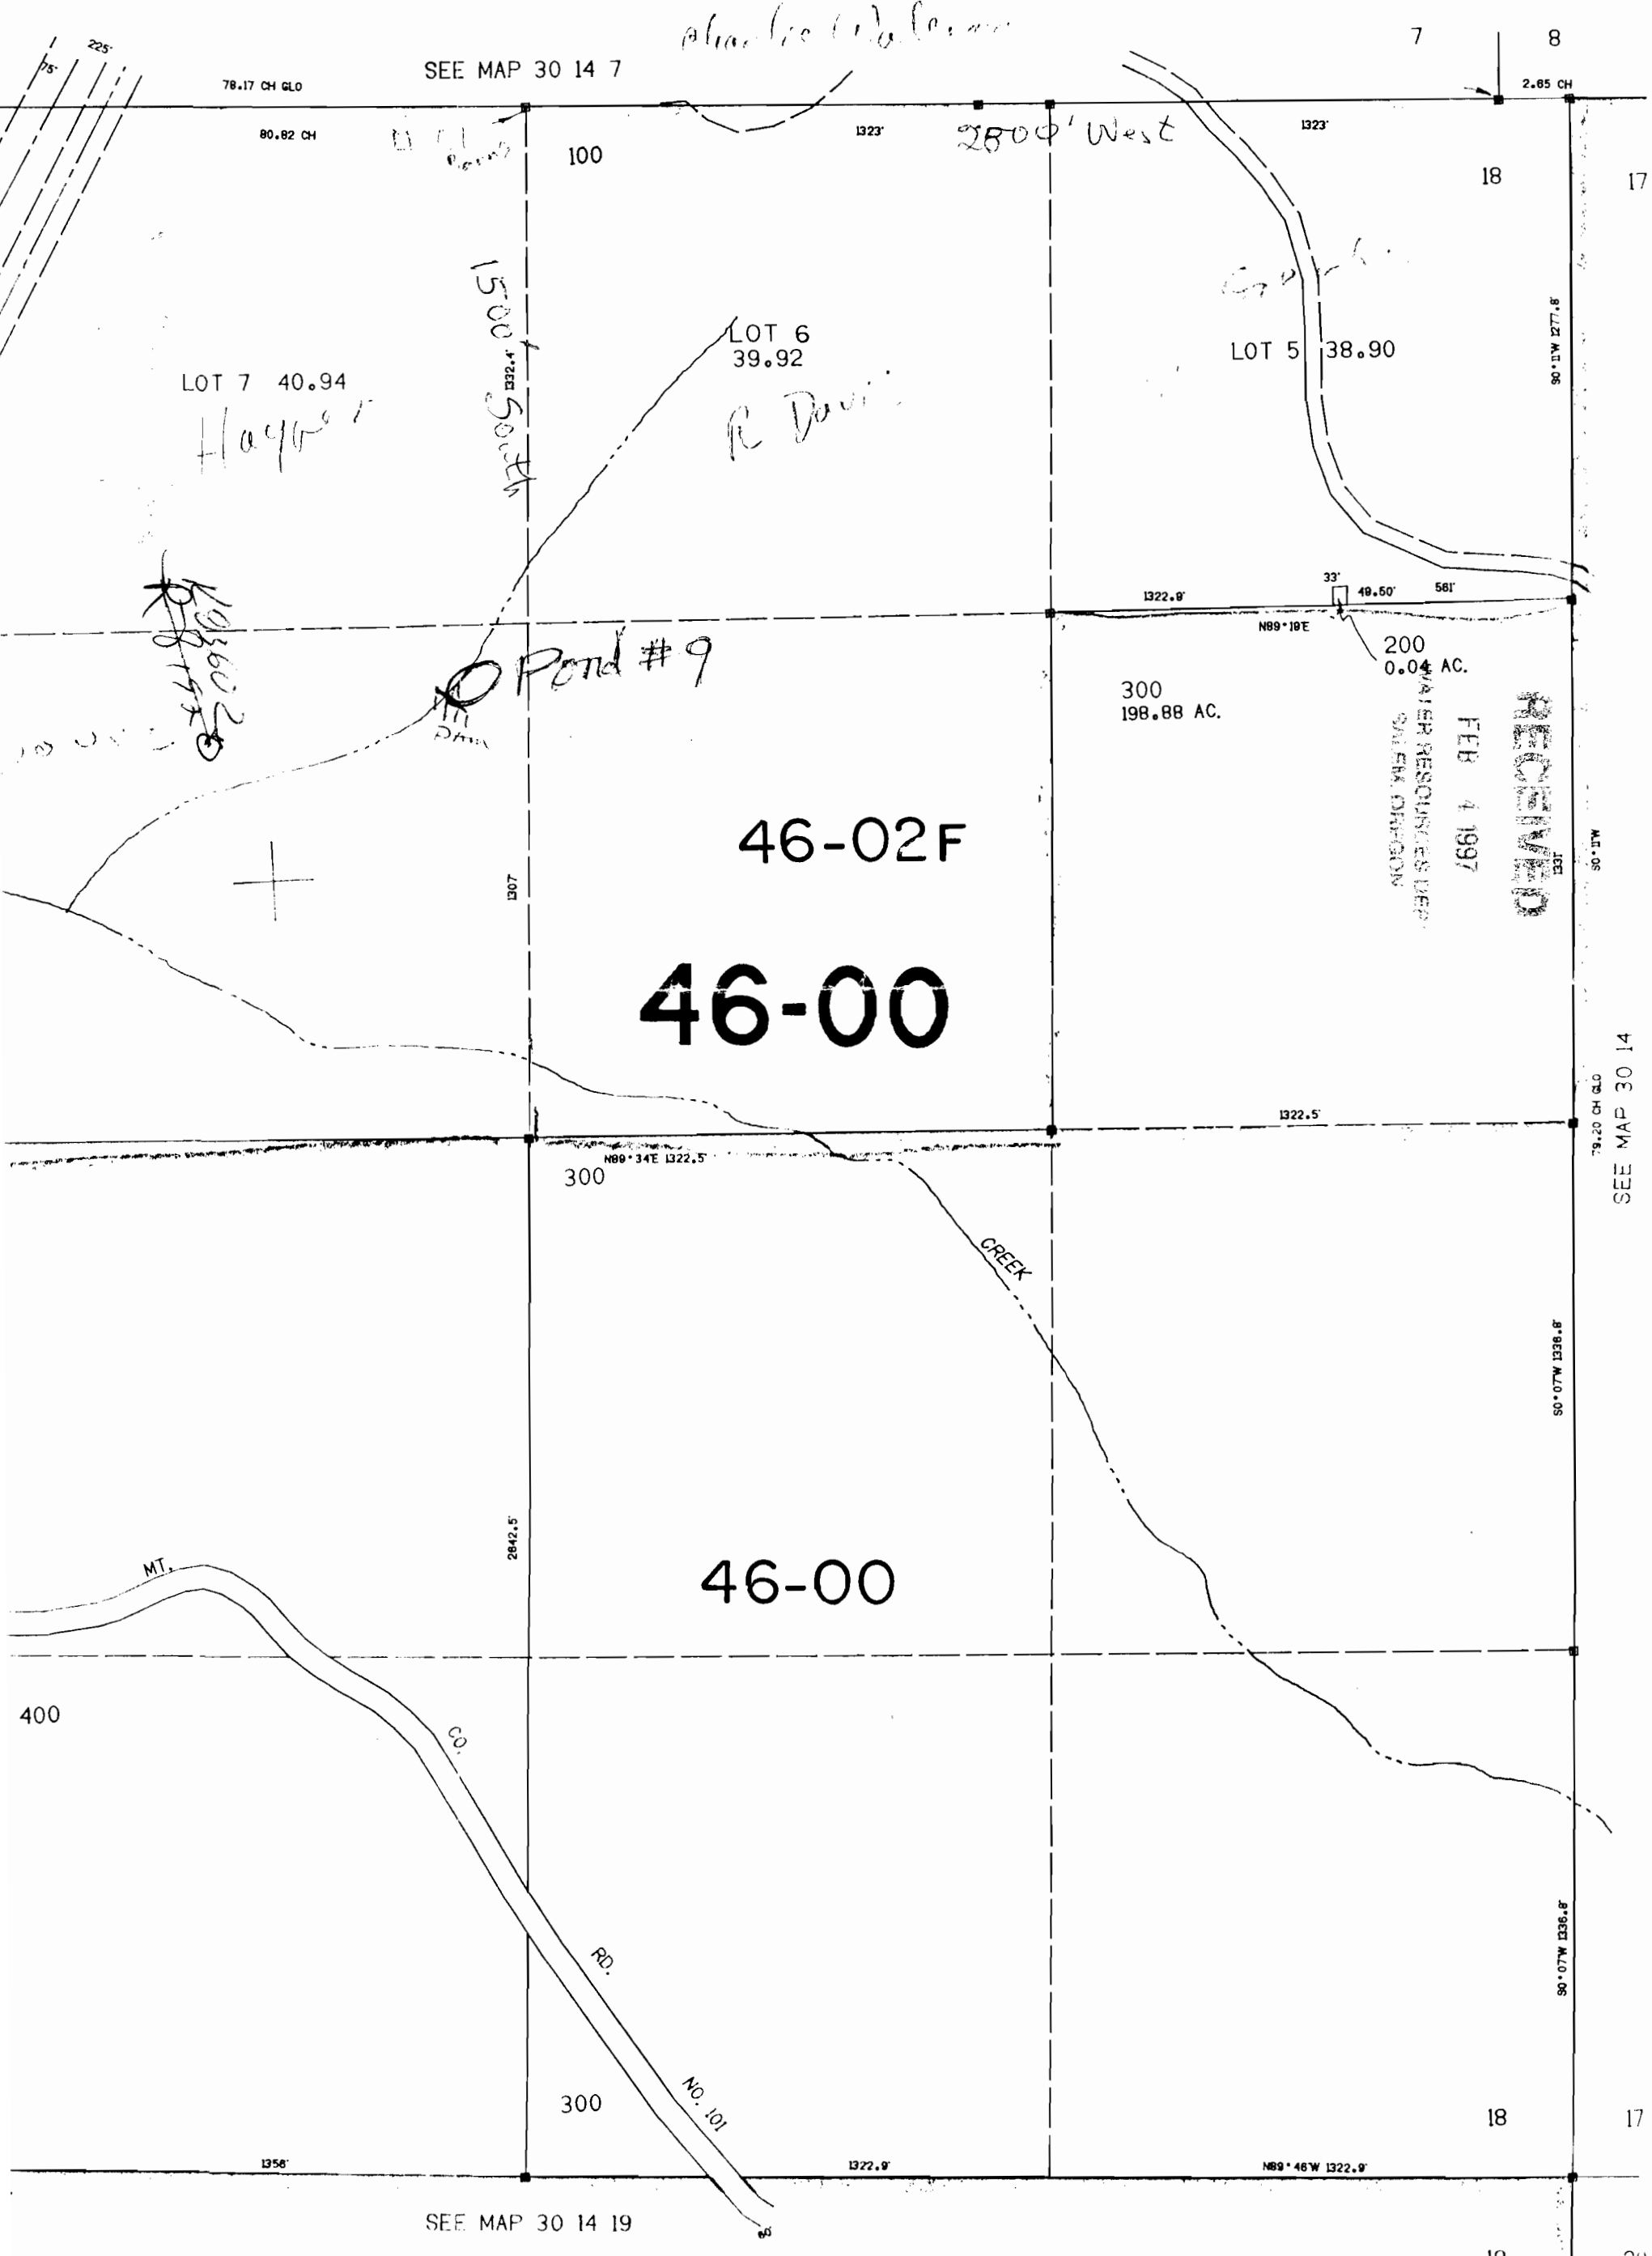


SECTION 18 T.30S. R.14W. W.M.
COOS COUNTY

1"=400'

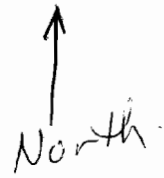

RECEIVED
FEB 4 1997
WATER RESOURCES DEPT.
SALEM, OREGON

SEE MAP 30 14

SEE MAP 30 14 19