

SW 1/4 T20S R47EWM

MALHEUR COUNTY

# 20 47

TAX LOT

# 100

Code

# 32

Refer

# 1026

Revised on  
2 - 6 - 98

1" = 1000'

CANCELLED  
NUMBERS

- 200
- 1504
- 1507
- 1304
- 1305
- 1506
- 1000

FOR ASSESSMENT PURPOSE ONLY

T.L. 400

1. South 299.1'
2. N140° 53' E 220.5'
3. N 66° 36' W 157.2'


Application No. R-84404  
Permit No.

**RECEIVED**

MAR 20 2000

WATER RESOURCES DEPT.  
SALEM, OREGON

Postnet Fax Note	7671	Date	1/30/99	Page	1
To	Brad Bowler	From	Malheur Co.		
Co./Dept.			Assessors Office		
Phone #		Phone #	(541) 473-5117		
Fax #	(208) 323-9191	Fax #			

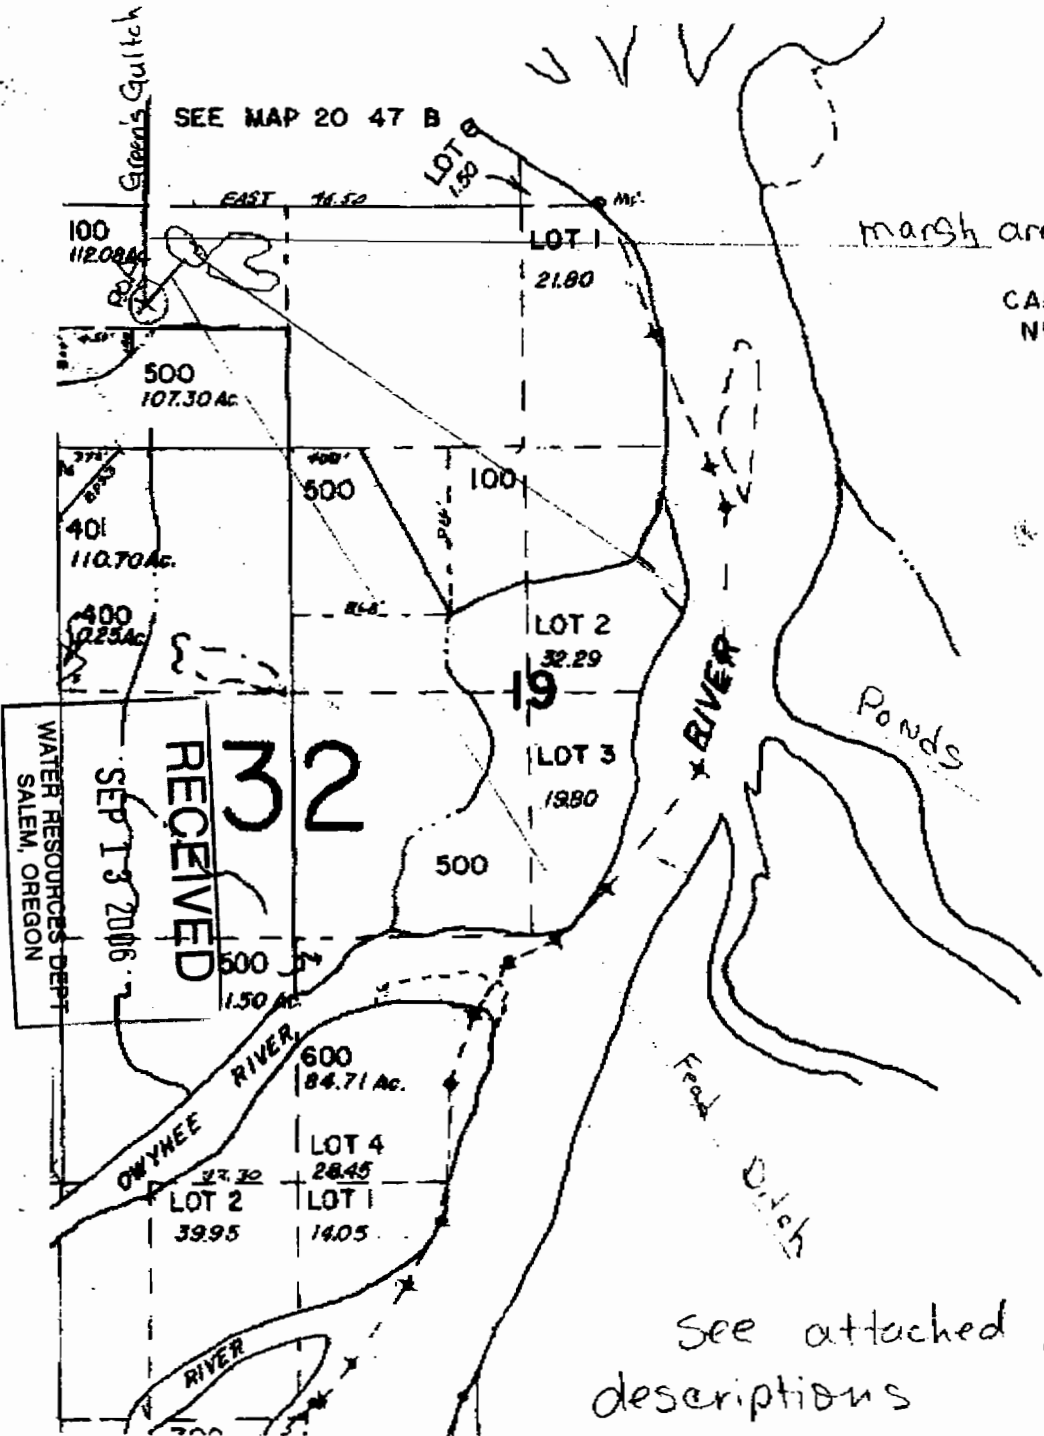

See attached page for legal descriptions